#15

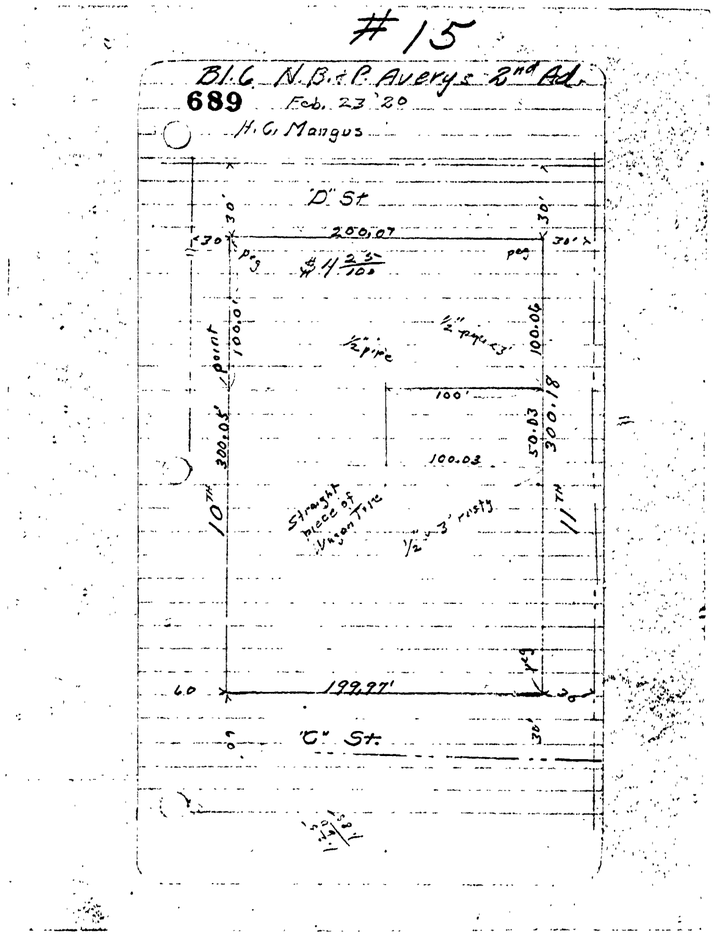

REEL 19 FRAME 053