C.S. # 695

Kiger Island Tracts

F.B. 25-1

1

FB #25

#695

Began Sec. cor. 24 | 19 / 25 | 30

Offsets S. 3.0

Bear S 89°34'E (37.5 lks) Distance 2566.

S 3.0
N 2.66
S .34
N 1.19
N 1.20

3/23/20

S 0°31'E from sec. cor. (90.185 lks) 24 | 19 / 25 | 30
Distance - 2652.2 to 3"
Square stake ¼ cor. 25-30.
S 89°46'E From ¼ cor. Sec. 25-30 to ¼ cor. center of Sec 30
Distance - 2536.6
Offsets

N 13.3 S 10.4
N 4.4 S 13.7
N 17.7 S 24.1
S 6.4

March 22-1920 T. Delzell Persons Barker
Weather - Cloudy.

Δ left 0°32' 286'

.00931
286
5586
7448
1862
N. 2.66266
N. 1.9
N 4.56
S 3.36
N. 1.20

2568 1.20 10236 17240

Δ = 0°01'

S 3.0 N 2.66

Δ right 0°05'

.00145
248
11660
5800
290
S. .36
S 3.0
S 3.36

2536.6

.00252 = Δ 8'
6.40000
50732
132680
126830
58500

Δ left 2°34' 297'

Δ = .04478
297
31346
40302
8956
Y = N 13.29964

Δ right 0°55' 648'

.01600
648
3888 00
648
S. 10.36800

Δ left 12' 1250

.00349
1250
17450
6980
349
N 7.3625

2

From ¼ cor. Sec 30 N. to ¼ cor. 19-30

Bear.
N 0°07'E

Offsets Sta. 10+71

∠ left. 11°58' 27'
W 5.6 E 4.6

∠ Right 0°20' 792'

Dist. = 2641.8'

.20734
27
145138
41468
W. 5.59818

.97827
27
684789
195654
26.41329

.00582
792
1164
5238
4074
E 4.60944

.99998
792
199996
899982
799984
191.98416

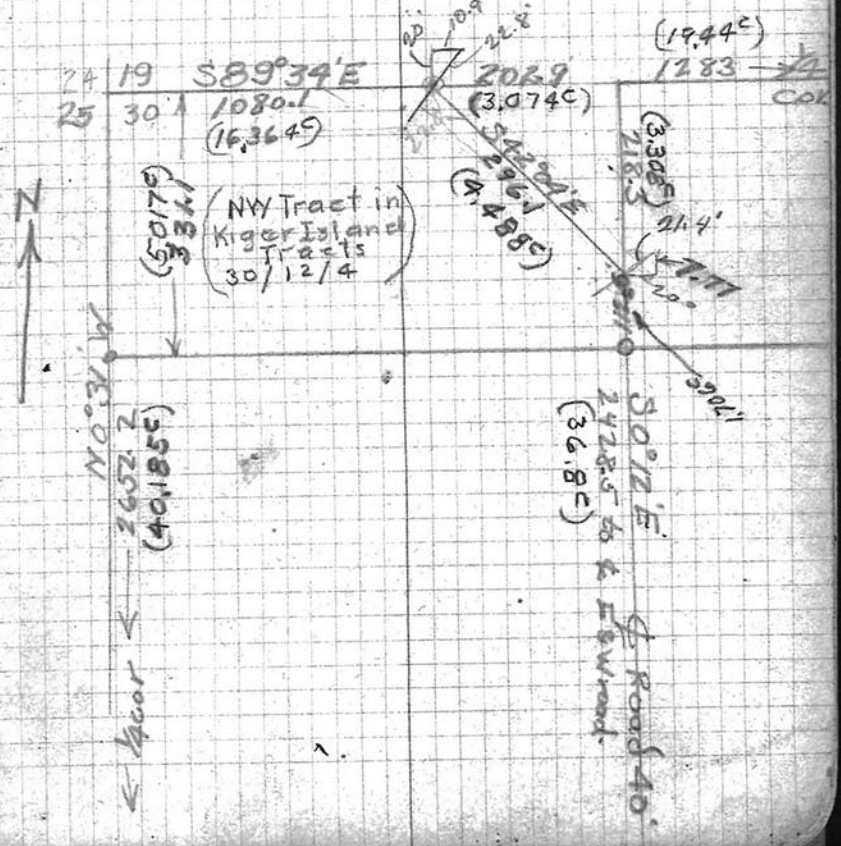

3

N. W. cor. of Lot which is N 0°07' E 990.6' from ¼ cor. center of Sec 30 falls in slough. Set Witness stk. on line N 0°07' E 43.4' from said Lot corner. Hollow dead Oak 48" West 15' from Witness cor. Said stk. is 2"x4"x3'
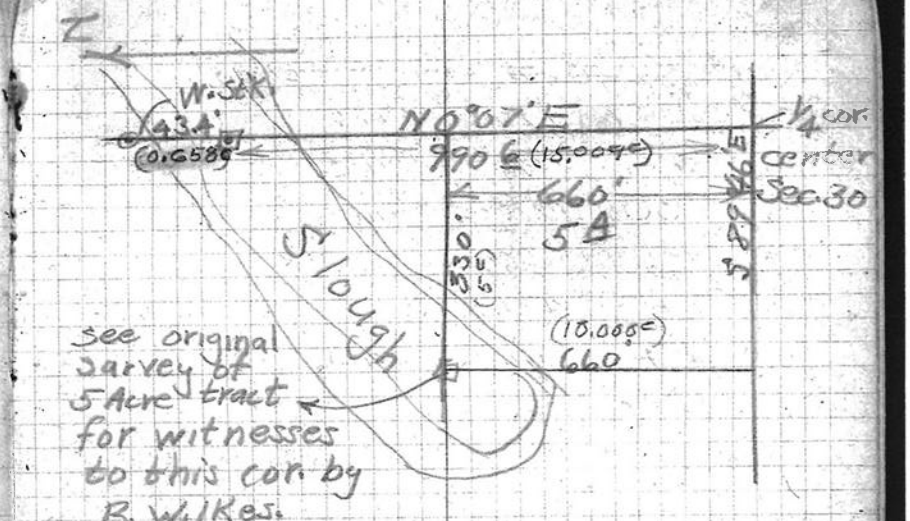
Reestablished cor. Sec. 24/19 / 25/30 with a ¾"x36" galv. iron pipe set 6" below surface. Also set a ¾"x14" galv. iron pipe N 87°28' W 20' from Sec. cor.