C.S. # 697

Hardcopy 14-8 #1

also see notes in file

F. B. 27-58

REEL 15 FRAME 176

F/B 27, P6. 58-59

58

C.S. #127 continued

Beginning at gun 661. 19.88 chs.

S. ½ T. 14-8

#697

1	N. 0° 51' W. (N. line of Edwards Cl. Est.)		6.826	
2			4.528	Set 2" bolt 34" long about
3	N 89° 09' E.		1.208	
4	To on W. bk Mill C.		.505	= 1.713 set 2" bolt
	From 3			
5	S. 35° 28' E.	- 50'	5.765	S. 75° E. 34 L
6		-9° 15'	1.648	
7			1.221	+.20 to L = 1.07
8	S. 50° 11' W.	+ 2° 30'	5.190	
9	S. 17° 30' W.		1.734	
10	S. 53° 07' E.	-3° 15'	5.696	N. 15° E. 1.52 N. 69° E. 1.13
11	S. 79° 45' E.		1.654	-.27
			-.270	
			N. 310	to Cl. line
12	S. 86° 19' E.		2.527	℄ Road
13	S 58° 01' E.		3.833	℄ road
14	S. 62° 12' E.		2.119	
15	North		3.500	set ¾" ϕ P N. .25
16	East		1.625	to NE. Cl.
17	North correction 10'43"	+ 5° 15'	3.264	set ½" x 1¼ I. E. .097.
18	East		1.597	
	Set 2" Pipe			

For E. B. Bowen March 24, 1920.

6820
4528
11348
402
15.375

1.208
.505
1.713

at 1.36 L. N.E. .30

5.765
1.627
1221
8.613

- 1.713 Ans. 1.07
L. .2 bank.
- S. 4° W. 1.05

at 2.54 - 1.47 = 1.07
N 10° E. 1.45 bank E. .25, S. 72° E. radius
set E. .71, S. 56° E. 1.70, S. 64° 45' E. down con. Cr.

3.468 // N. 7th Cl. line
5.788 W. of el. cor. to ℄ on W. of bridge.
9.256 2.739
.270 .212
9.524 2.527

.02984 = 1° 43'

3.25) .0970 (.030
650
3200
at .25 N set 3200
.02984 × 3.25 = 2975
225
2750
2600
1500
14920
5968
074600

.097 E.

59

	N 0° 19' E. correction E. 14'	+9°10'	8.013	line N. 33' E.
19		+12°55'	5.325	
			+.021	
	Striking W. of cor.		.053	3/4" pipe set.
20	N 0° 33' E. correction 22' E. (N 33' E.)	+ 9°	2.708	
21		+ 7°15'	6.190	3/4" pipe .170
22		- 1830'	- 1.375	+.177 E. .100
C.C.	S. 88° 23' E. correction N. 2°02'	- 3°30' (N. 89°35' E.)	4.895	To cor. 35 36 = 4.786 bet. cors.
35 36	Set 1" pipe	bicycle frame		
	Maple stump 44" N 55° E. .32			30 to notch
	Back to N.E. cor. of Edwards Cl.			
	South			
24			4.335	
25			11.587	
	Set 1 1/4" Shell with		+.483	cog wheel on point
	Oak 10" N 88° E. .716			chs.
27			10.392	
			+.286	
	Set casting 1 1/2" x 2 1/2" x 16" with cogs.			
	Oak 15" N. 61° 15' E. 2.262 chs.			
	N.E. cor. Stone 4"x5' S. 2° 20' W. 1.135 "			
	From ⊙ 2.392 No. of △ 27			
28	West correction N. 14' W.		32.00	
29	S. 3°	+16°16'	2.651	= +.133
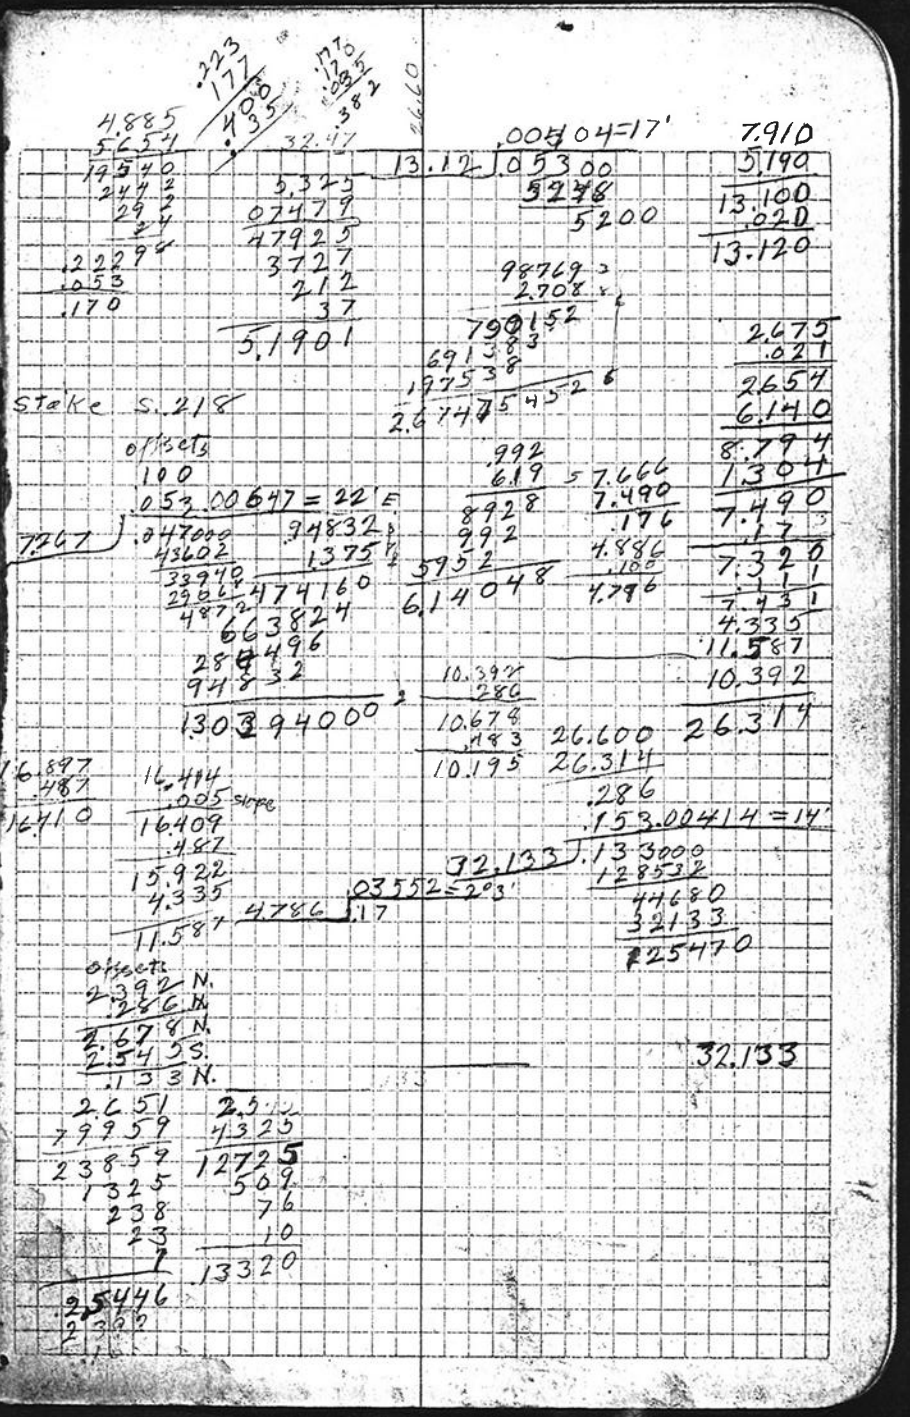
corrected old line 1°51'