For S. F. Yates

700

BLOCK 15

COUNTY ADDITION

CITY OF CORVALLIS

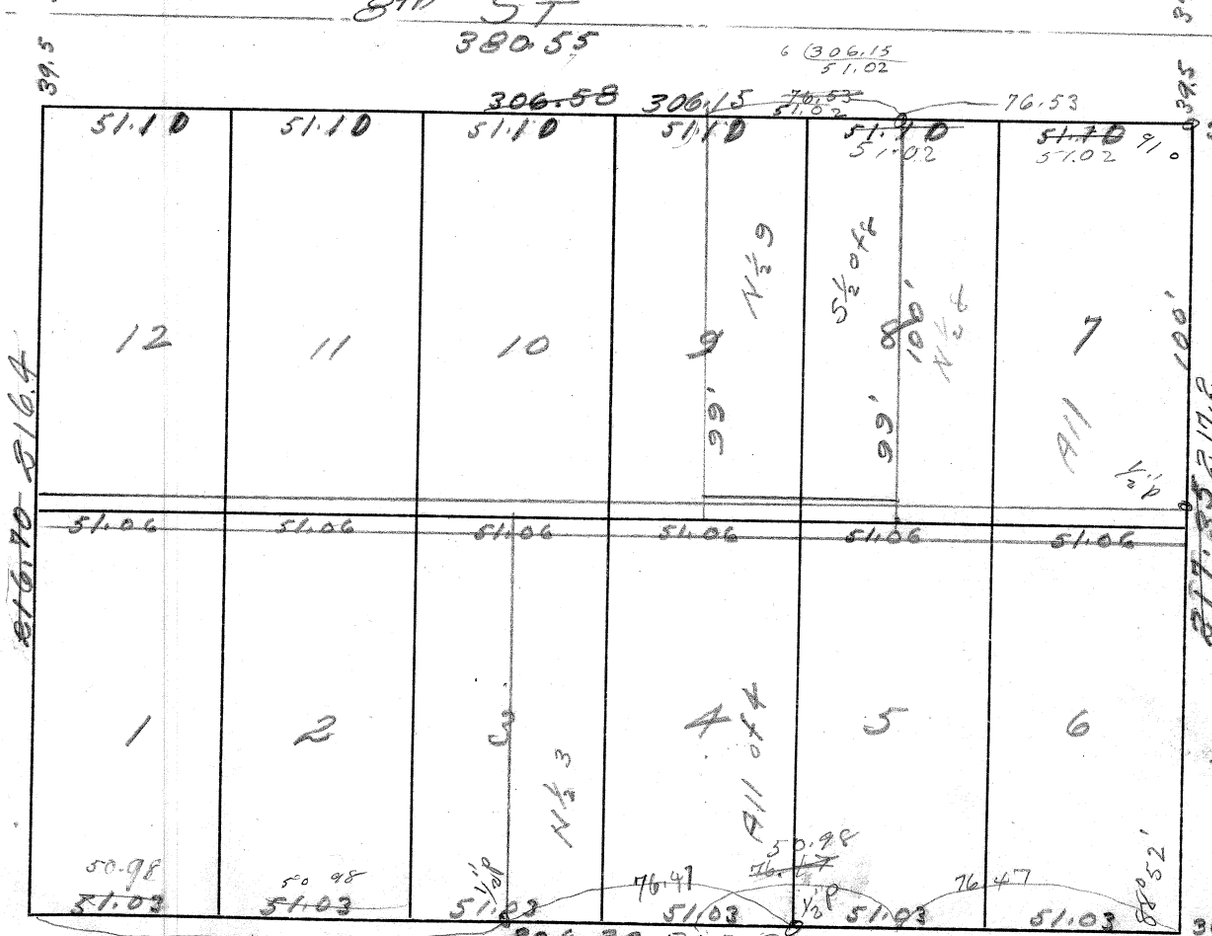

50