701

701

200

701

701

C. S. 200

T. 11 S. R. 4 W., W.M.

Scale:- 1 in = 5 chs

corner post

East 32.00

3" I.P. pipe

5.558

22.08

16.522

brake lever

(N. 3° E. 28.00)
13.40

East 50.31 to stone
31.861

1¼" I.P. pipe

.187 fence

15.00 pipe to stone

Claim line

Stone is .190
W. of Cl. line

South 26.202

N. 2° 31' E. 32.959

N. 2° 31' E. 40.817

20.48 a

62.52 a

S. 3° 00' W. 33.50

3" I.P. pipe

Total 83.14 a

S. 33° 35' E. 9.424

1¼" I.P. pipe

East 7.575

1" rod

.777 South 6.084

pipe

S. 64° 06' W. 7.027

1.459

Stone

3" I.P. pipe

D. D. Stroud Cl. 44 west

plow share

1 iron 1.149

14 a

1.40

1.836

pipe

3" I.P. pipe

5.284

C. & E. R. R.

pipe

S. 54° 55' W. 6.124

pipe

COUNTY ROAD

11.284

N. 89° 02' E. Anthony Roberts Cl. 41

Ira Hunter Cl. 43

4 #701

C.S. 701 F/B # 25, Pg. 4 April-17-1920 Weather-Fair. ↑ - Delzell 11-4

C.S. #200 Continued

~~Began at 3/4" pipe thence~~

Sta.	Line	Dist	Bear.
A	AB	990'	West.
B	BC.	1729.5	South.
C	CD	500	East.
D	DE	400.6	S.
E	EF	51.3	S64°06'W
F	FG	95.9	West.

cen. of Co. road.

note: I found the length of line from "A" to 3/4" pipe due West to be 31.913chs. instead of (31.761) as given by M. Wilkes on Oct. 17-1913.
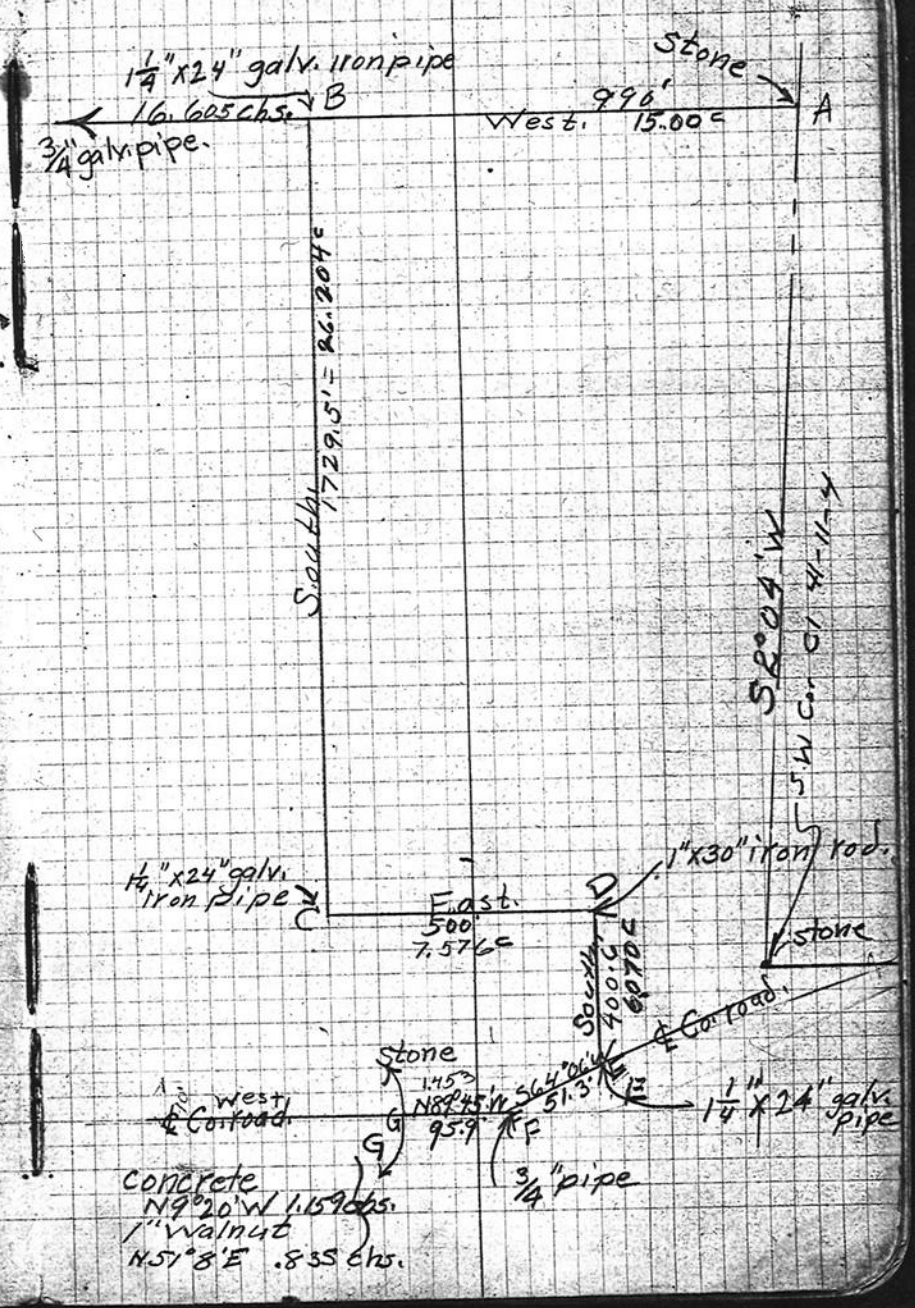
T.W.D.