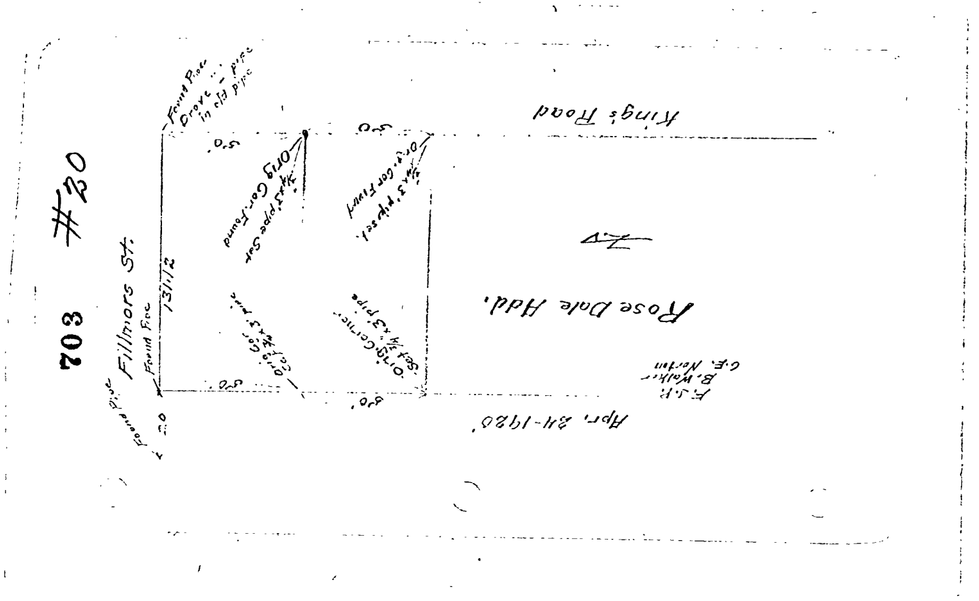
#20
203
Fillmore St.
Rose Dale Add.
King's Road
Apr. 24-1920'
Found Pipe
Found Pipe
Orig Cor. Found
Orig Cor Found
Found Pipe
Found Pipe
Found Pipe

703 #20

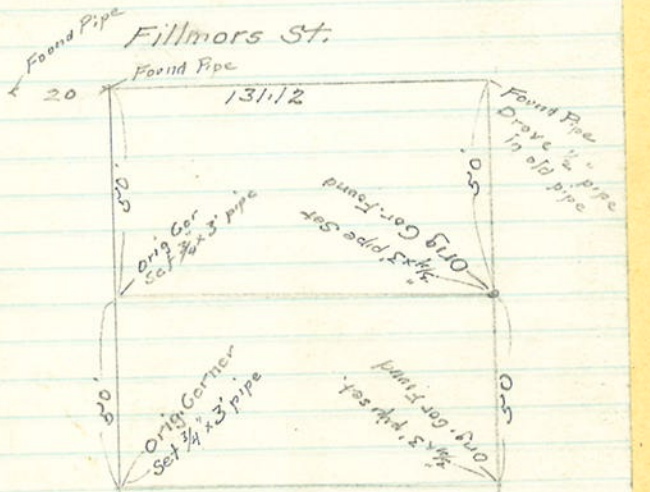
Found Pipe
Fillmors St.
Found Pipe
20
131.12
Found Pipe
Drove ½" pipe
in old pipe
30'
Orig Cor Found
¾"x3' pipe Set
Orig Cor
Set ¾"x3' pipe
30'
Orig. Corner
Set ¾" x 3' pipe
Orig. Cor. Found
¾"x3' pipe Set
30'
Apr. 24-1920'
Rose Dale Add.
King's Road