704

BLOCK 7 Lot

North College Hill ADDITION

CITY OF Corvallis

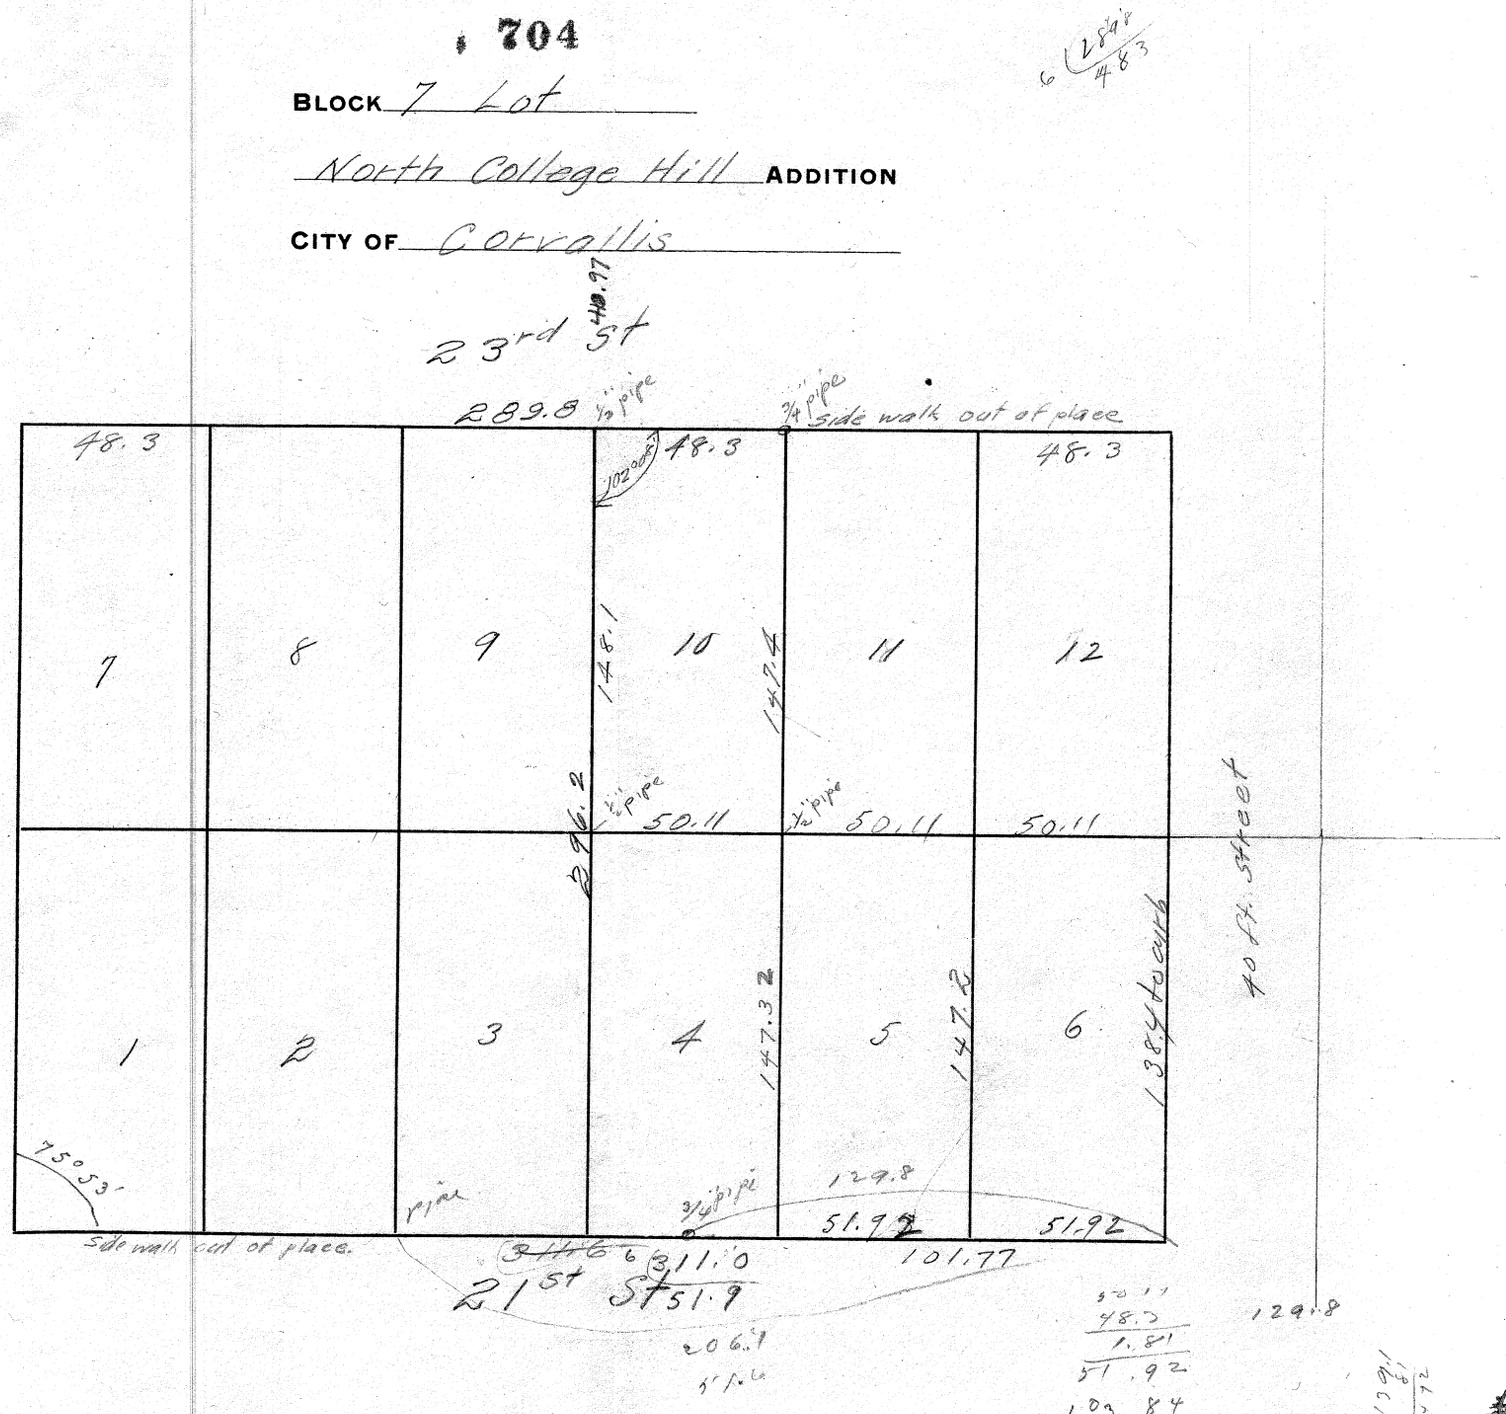

50.11
48.3
1.81
51.92
103.84
25.96
129.80

129.8

1.81
1.72

69