712

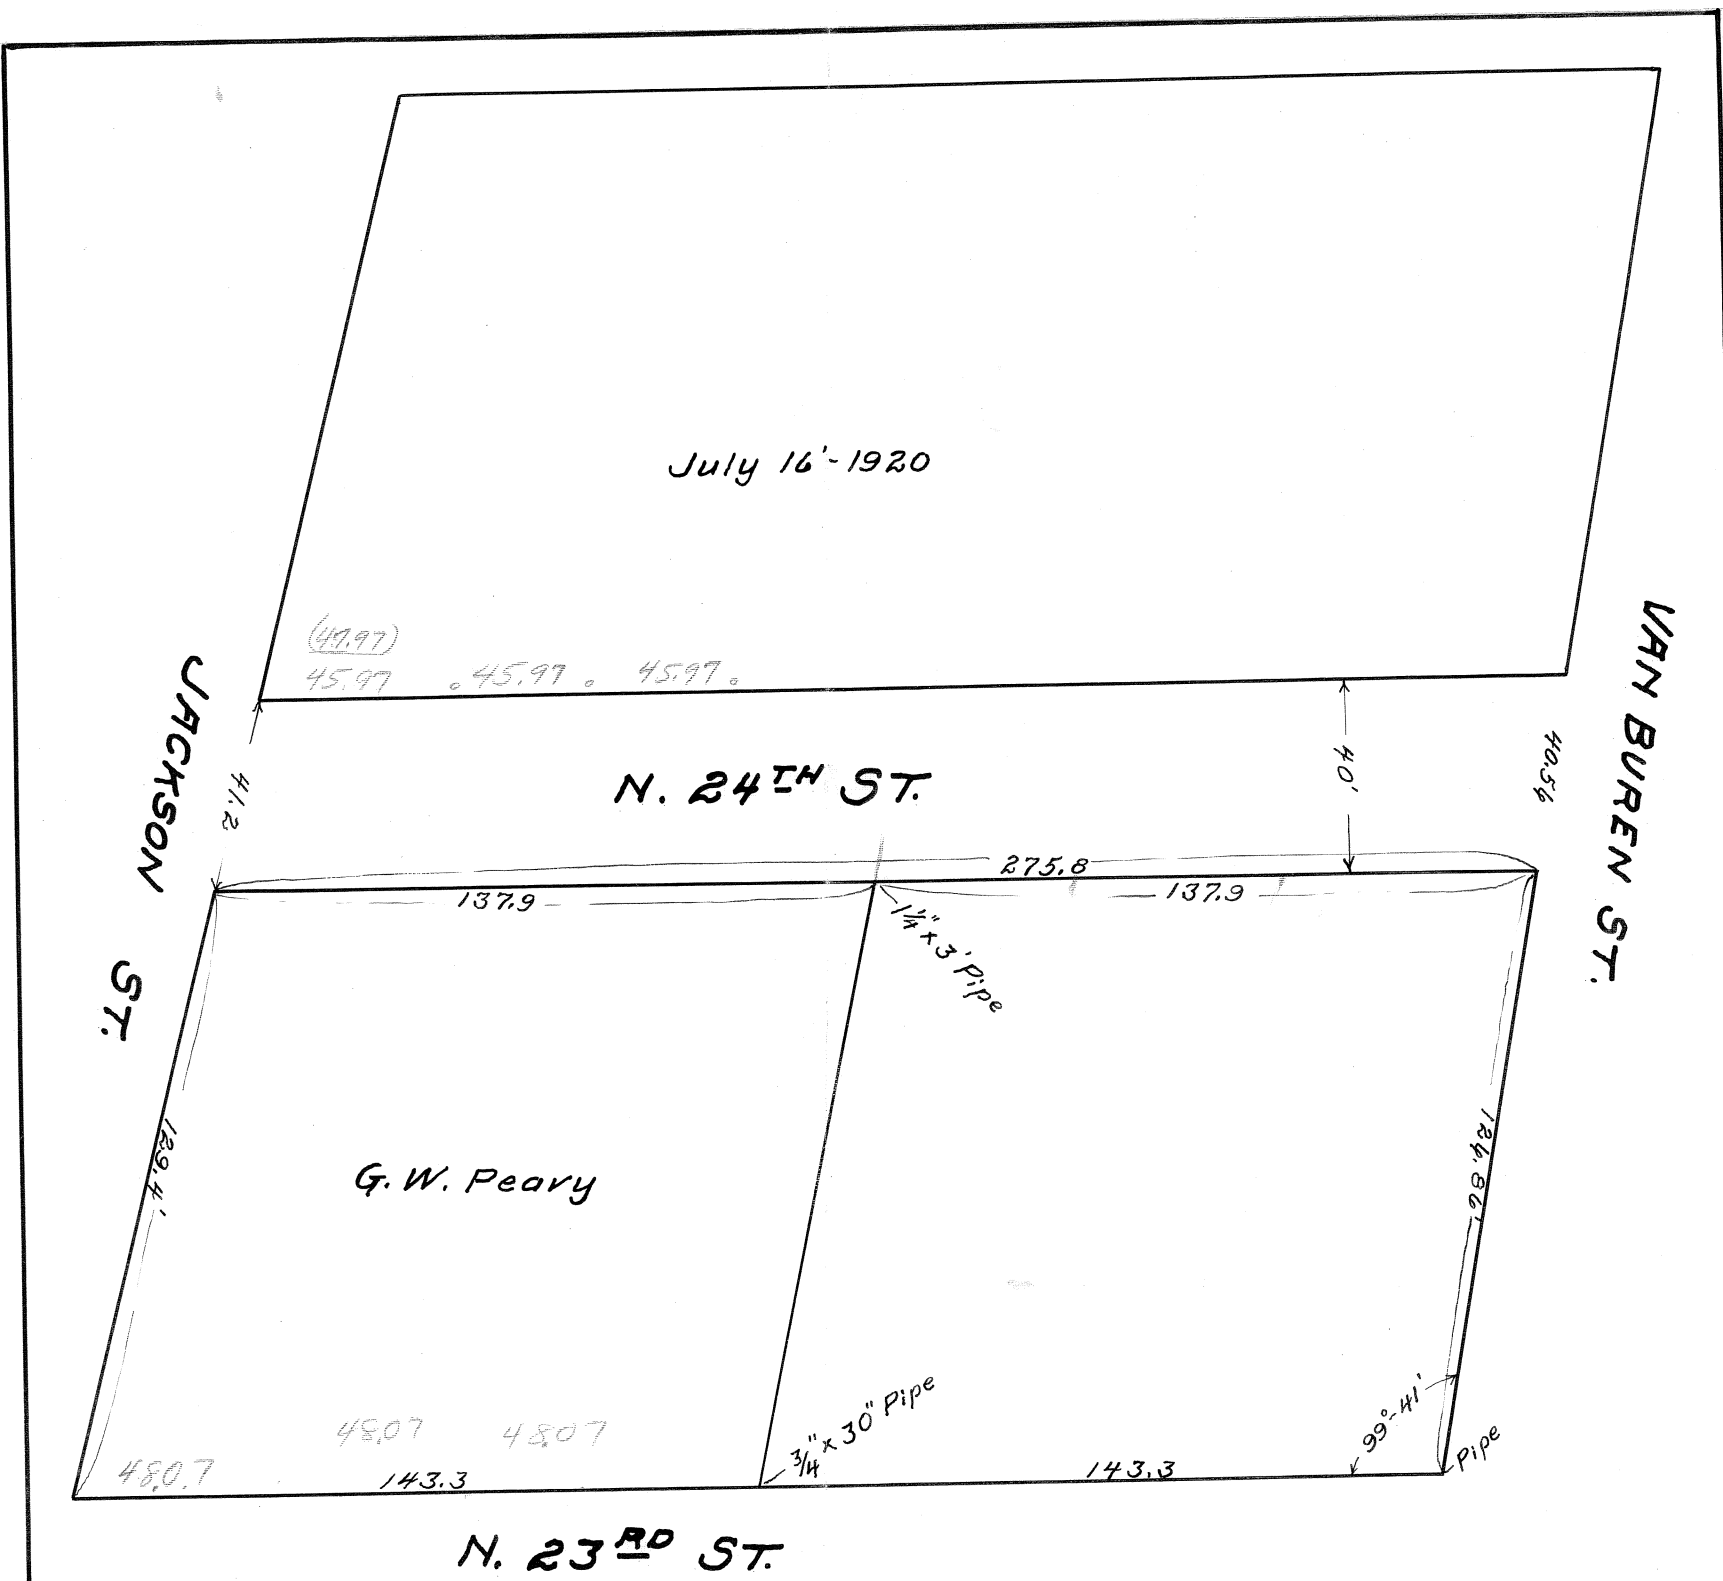
July 16'-1920
(47.97)
45.97 . 45.97 . 45.97.
JACKSON ST.
VAN BUREN ST.
N. 24TH ST.
41.2
40'
40.56
275.8
137.9
137.9
1¼" x 3' Pipe
G. W. Peavy
129.4'
184.82'
48.07
48.07
48.07
143.3
143.3
3/4" x 30" Pipe
99°-41'
Pipe
N. 23RD ST.

24