C.S. # 714

See notes in file

F.B. 25-7

7

C.S. 714, F/B #25, Pg. 7-8

#714

C.S #237 For Henry Sheake

July 21, 1920

Parker-ch.
Sheake-over
Watkins-ch.

Beginning 0.100 chs E of NW cor of 10" fnc. post on NE cor of DLC of Natzger

Run Southerly

Sta	Dist	Defan	Mag Bear	Cal. Dist
0			90 30 E	
1			S 0 45 E	
2			S 0 45 W	
3			S 0 30 W	
4			S 0 30 E	
5			Hit 15 Link E of cor	

Began at 3/4 pipe on SW cor of St Clair Claim. Run N and hit 1.73 chs E of post 45 links approx bear

24" Oak bear NE 2.30 chs

26" " " N 10 E 1.05 chs approx bear

Back to point 0.020 chs of line fnc. betw Tatom + Sheake which is 14.063 chs N of SW cor of St Clair Claim #47

See M.

+ Watkins-T 12 S-R 6W

N or W Larsen

sec.

⇒ pt. is 1.52 chs E of 3/4 pipe which is SW cor of St Clair Claim

(This line didn't suit Parker so we return the same—Checked)

Supposed to be NW cor.

Parties concerned did not care to have lines run to established corners on acct. of expense for such a small tract. Therefore corners were set with reference to lines which may later be established.

8

BS from pt on random line to point S on random line

Sta	Dist	Deg. Mag.	Calc
6	7.875	92° 53' R	S 82° 45' E
7	Not Mon.	Southerly to middle of	
8			
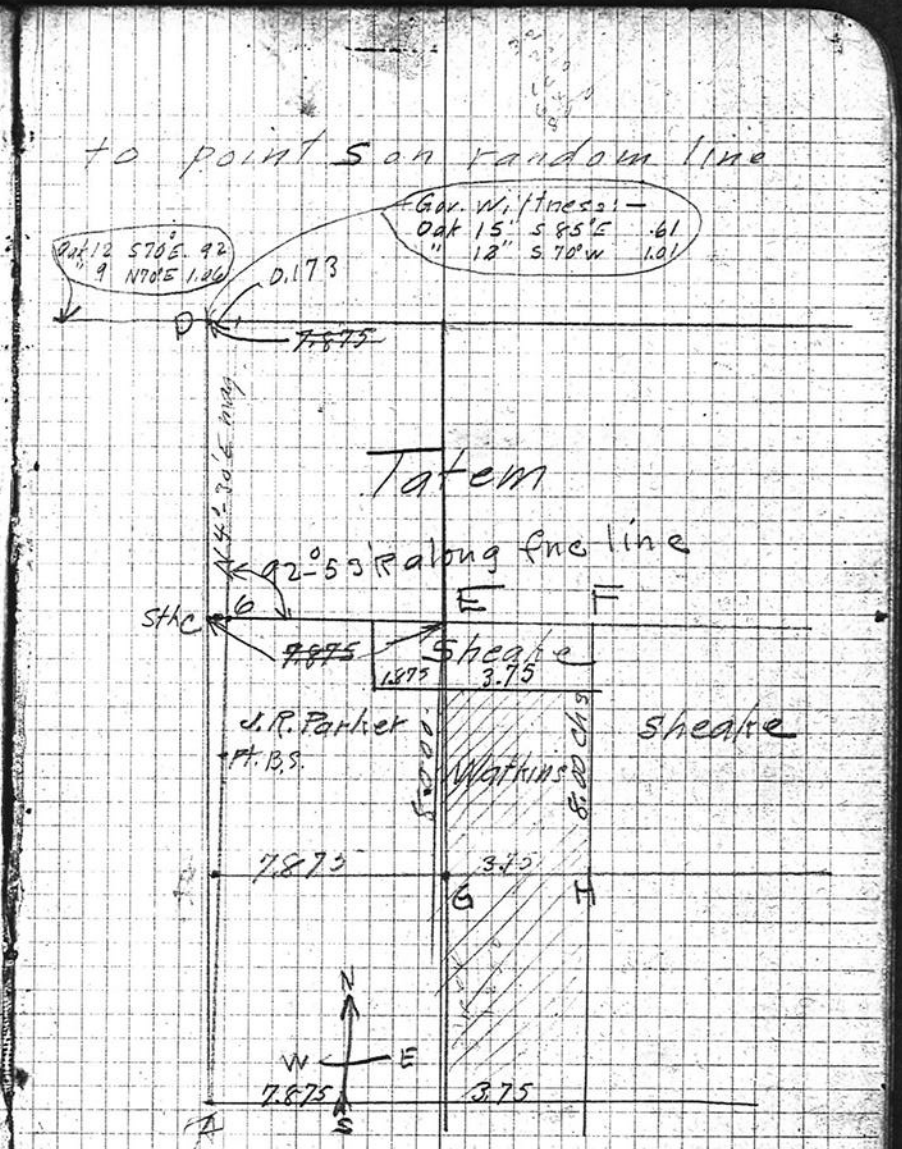
Description:—
Beginning at a point on the S line of the W. St Clair Cl. #47 — 7.875 chs. E of (¾" pipe which is SW. cor. of said claim) run E along line 3.75 chs, thence N parallel to W line of said claim 8.00 chs., thence W parallel to S line of St Clair Cl. #47. 3.75 chs. thence S 8.00 chs to point of beginning containing in all 3 Acres.
W. W. Larsen