C.S. # 721

See notes in file

F.B. 25-18

CS "721" F/B 25, Pg 18-~~24~~ 27

424

18 Road Survey

Sta	Dist.	Defan	Cal Br	Mag Br	℄ Rd
	Begin at a 1¼" bolt				Set tack
	Set over	4.6' W of bolt			
	B.S.	on 3" □ bar	on cor	at	
0	811.7	97°30L	S7°45E		4.6L
1	305.1	10°08R	S2-23W		3.4R
2	475.2	2°23R	S4°46W		℄
3	336.8	3°53R	S8°39W		℄
4	424.5	14°15L	S5°36E		℄
5	482.6	26°34L	S32°10E	back 12½ Forward 17.0'	near gate ℄
6	461.9	——	S82°10E		℄
7	123.5	20°02L	S52°12E		℄
8	167.1	——	S52°12E		℄
9a	100.8	13°-9'L		at 9 123 on 10	
9	340.3	20°59L	S73°11E		℄
10	291.0	12°16L	S85°27E	at 10 83 on 11	℄
10a	100.8	4°-03'L			
11	401.1	4°03R	S81°24E		
12	539.5	7°51L	S88°15E	Correct 24' N of Sarah 3.8	
13	239.6	——	S89°15E	S88°45E	15.5
14	281.2	37°56R	S51°19E		
15	123.0	——	S51°19E	S51°15E	
16	423.8	3°15L	S54°30E	S54°0E	
17	145.9	180°	N54° W Back on line		
18	500.0	36°12L	N29°15E	N28°30E	
19	306.3	5°42R	S85°04E	S84°45E	

T. 10 + E S. R6W #721

Hoskins to Alexander School

Aug. 9, 1920 Cpm C.A. Frantz

mill property Mag bear = N8¾°W

Use as base S89°55E

(99°24'L Down the bottom Baylis + Mosier + Lyday Fnc is 2.3'L and 2.8'R
Br. N89°15'E calc 707.6' W of 5th near Rd.

Hot Aug. 10, 1920 - Chain: Mackey + C. Frantz ⊼ Larsen

About 20'S of Lyday fnc in pasture on knoll W of Scaggs Hse

30 S of Scaggs Hse bank.

E of 8" Maple 20 near ft. of slope.

at S base of three maples 15 S of fnc.

20'S of Bush's Sarah SW cor. N

Maple 20'L 6" stump 2' NW

Cor. of cross fences 20' NW Redfir

W ⊗ of creek 15 Aug 11 Mackey + C. Frantz Ch. ⊼ Larsen Hotter

Top of hill near Jacket + Harvey's nest

Road could bear N, if necessary

40' S54°E large fir Swamp 50'L

Fowler's sheet fold 40E of W fnc + 20S of N fnc

Road Survey Continued

Sta	Dist	Def L	Co Bear	Mag Br.	℄ Road
20	390.5	32°52'R	S52°12'E	S52° E	
21	213.8	14°37'R	S37°35'E	S37°15'E	
22	99.1	25°33'R	S12°02'E	S11°15'E	
23	469.0	10°26'R	S1°30'E	S0°-30'E	
24	351.6	51°07'R	S49°37'W	S51°30'W	
25	312.4	20°01'L	S29 30W	S31° W	
26	734.7	27°~~49'~~L	S1° 41'W	S2° W	
27	354.6	25°34'L	S23 58 E	S22 30'E	
28	192.2	52°04'R	S28°11'W	S29°15'W	
29	265.5	29°25'R	S57°36'W	S58°45'W	
30	213.2	26°54'L	S30°42'W	S32°W	
31	857.6	29°04'L	S1°38'W	S2°45'W	
	Back to:— Sta 26 B.S. on 25				
26	211.3	19°49'R	S49°19'W	S51°W	
26A	496.4	37°41'L	S11°38'W	S12°45'W	
26B	135.9	19°17'L	S7°39'E	S6°15'E	
26C	179.8	26°45'L	S34°24'E	S33°15'E	
26D	148.0	17°03'R	S17°21'E	S16°E	
26E	601.0	37°42'R	S20°21'W	S21°45'W	
26F	777.4	17°50'L	S2°31W	S3°45'W	
26G	868.4	2°54'R	S5°25'W	S6°30'W	
26H	121.6	64°47'R	S70°12'W	S71°45'W	
(31+ side shot	17.8	29° R	~~N3°54'E~~ on Stake)		
32	120.8	71°50'L	S1°38'E	~~S0°15'W~~ S1°50'W	

Aug 12, 1920 - Alone in forenoon
Frantz, Fowlers, Scaggs, Norton, Mackey
afternoon.

6' E of Fowlers fnc. E of clearing. Start around hill
Near top of big fir 46 ft N SW of creek.
S of Fowler road 50 W of Creek
10 N of rail fnc. 25 W of 16" blazed fir.

35.5' E of hub W.G. sor 42' E of Fowler + Frantz fnc.
21.6 147°-05'R to SE cor fowlers S.W. Watson
Going around knoll

Stk W of rail fnc

Aug 13, 1920

Road could go 20' RR
30 R of Fowlers fnc Side slope 31° 60% 2
20' W " " Road should follow curve at hill
Side slope 32° - S of fnc 30' - 26' levels off -

In Nortons Fld 30' E of Fnc
15' W of Rail fnc
In Greig Fld 8 E fnc +57's line fnc.
(Set on fnc line LL 93°35' along line fnc E
Bear is ~~N3°54'E~~ N3°54'E

~~To~~ supposed ℄ Rd. near ravine

33	78.8	83°21L	S84°59E	S84°E	
34	48.8	51°29R	S33°30E	S32°45E	
35	130.7	32°34R	S0°56E	S0°30W	
36	134.0	10°40L	S11°36E	S10°E	
37	322.5	13°16R	S1°-40W	S2°45W	
38	493.7	0°06L	S1°-34W		set 0,8L
39	818.8	0°06R	S1°-40W		
40	494.4	8°33R	S10°13W	N89°45W	
41	267.5	——	S10°13W	S11°15W	
42	65.0	63°01L	S52°48E	S51°45E	
43	75.0	12°50L	S65°38E	S65°E	
	Set	on 40	BS on 39		
44	498.2	5°26R	S7°06W	S8°W	
45	227.2	4°41L	S2°25W	S3°30W	
46	84.6	22°18L	S25°48E	S24°30E	Reset
47	146.9	44°59L	S70°47E	S69°45E	
48	100.0	5°0R	S65°47E	S65°E	
49	221.2	29°42R	S36°05E	S37°45E	
50	99.5	24°39R	S11°26E	S10°15E	
51	129.0	16°07L	S27°33E	S26°45E	
52	497.6	19°53R	S0°40E	S6°45E	
53	186.6	——	S0°40E		
54	873.5	15°05L	S22°45E	S21°15E	
55	233.0	——	S22°45E		
56	476.8	67°43L	N89°32E	S69°30E	

abt. 50'w of Greig N+S fnc.
-28 w " " " "
10 " "
E of fnc 20'
" "

E of fnc 20'
Bank of slough SW of barnyard.
N Bank of creek
S " " "

10'W+40's of lg shed. Road can shift
20'N creek. 10' fill required.
Side hill 20's creek.
Greig's clover 40'E of fnc.

On knoll in pasture

30 W of fnc W of lane
On side of knob 10's W lane
6'N of E+W fnc Greig oats
50' N of Cr.
Sth is 3.2'E of old 34 leg sth. 20'S Samson lpw

Sta	Dist	D.L.	Bear.	Mag. Bear.	Vert. ang.
57	282.2	0°03'L	N89°29'E	S59°36'E	
58	452.3	18°02'R	N72°30'E	S71°45'E	
59	238.1	23°27'R	S49°03'E	S48°15'E	
60	496.5	28°10'L	S17°13'E	S76°15'E	
61	479.5	21°32'R	S55°41'E	S54°30'E	
62	230.5	41°14'R	S14°27'E	S13°45'E	

Set on Sta 20 +8.0 BS on 19

20	451.2	97°37'L	N2°42'W	N2°15'W	

Sept. 28, 1920

Resurvey for road along River - Set on 15 from 14 S51°19'E

Sta 15	98.4	19°29'L	S70°48'E	S70°30'E	+8°27'
16a	185.3	—	"	S70°30'E	-2°07'
17a	302.5	28°18'L	N80°54'E	N81°E	-1°30'
18a	275.	10°38'L	N70°16'E	N70°30'E	-0°20'
19a	300.5				+0°5'
20a	45.	65°31'L	N4°45'E	N5°30'E	

Move to 26

21a	Iron pipe				
26	BS on 188.5	17°07'L	S12°23'W	S14°W	-2°48'
26a	432.0	13°24'L	S1°01'E		+0°03
26b	376.8	25°37'L	S24°38'E		+3°
26	192.2	49°40'R	S25°02'W		+3°
26F	502.2	17°53'R	S42°55'W		-2°

9°09'R to post on Samson N+S line

Old survey stk. on Simson N+S line 20S of ac

In wheat fld - Could go 60R

N Edge of pasture in oat fld -

65'S of Grantsville line.

In wheat fld 100' SW of Cr. 100' NE of Hse

Sight on NW cor C Frantz

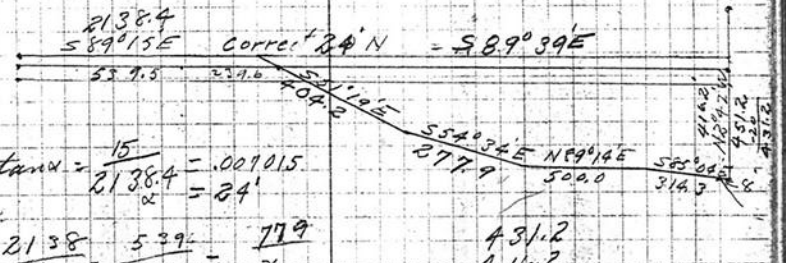

460 of 35'S of Riv bank.

Set N. 12 feet

45'S of cor. - Set 20S of cor.

45'S of Riv overhang Bank

Iron pipe SW cor of Watson Ol.

Creep for Norton

26F at Sta

Sta	at Sta.	Dist from ↑	Interior ∠	Bearing	V. ang.	Diff. Elev.	Elev.	
1	0	811.8	190°07' R		-0°45'	-10.6	07.2	Euchiamute Riv ℄ 80 L ± 40' lower
	+100	711			-0°55'	-12.9	4.9	side slope R 14° 30' L 40°
		611			-1°05'	11.5	6.3	
		511			-0°50'	-7.4	10.4	
		411			-1°08'	-8.1	9.7	
		311			-0°51'	-4.6	13.2	
		211			-1°06'	4.1	13.7	
		111			-2°51'	5.5	12.3	
		11			+2°30'	+.5	18.3	
	1	100			-2°30'	-4.4	13.4	
		200			-0°53'	3.1	14.7	
		300			+0°58'	5.1	22.9	
	2	400			+1°06'	7.5	25.3	
2		100			-2°47'	4.8	20.3	side slope R 17° 30' L 10°
		200			-2°16'	7.9	17.4	
		300			-0°50'	4.4	20.9	old Road bed 5' higher
		400			+0°16'	1.9	27.2	
		500			+0°28'	3.2	26.5	
		475			+0°17'	2.3	27.6	
	3	337	sight on hub		-1°-0	5.9		
4		237			-1°57'	8.0	19.6	
		125			-3°35'	7.4	20.2	
		100			-0°7'	.2	27.4	
	5	42.5			+0°32'	3.9	31.5	
		11.3			+0°48'	1.5	35.0	
	hub	57			+0°17'	.3	30.5	

Sta	Stn	Dist	Azm	Bear	Vang	Diff	Elev
6	5	48.6			-3° 6'	5.0	31.5
		294			+5°16'	1.4	37.9
		220			-1°20'	5.1	31.4
		123			-0°45'	1.7	34.8
		113			-1°20'	2.7	33.8
	Pk	67			+1°18'	1.5	38.0
		92			-0°15'	.4	36.1
		400			-2°05'	14.6	21.9
	7 Hub	46.9			-1°00'	8.0	28.5
8	7	123.5		~~152°~~ ?	+1°-0'	2.5	
		20			-11°	5.7	26.0
	9	167			-1°52'	5.9	22.3
9	10	340			-2°38'	15.0	20.6
	11	291.0			-2°19'	11.4	05.6
11		36			-9°17'	5.7	+9.2
11	12	401.1			-1°20'	9.3	+3.5
12	13	539.5			-0°17'	2.7	-0.1
13	14	239.6			+0°12'	0.1	-2.8
14	15	281.2			-0°05'	0.2	-2.7
15		28	sight on E'		-12°-0'	7.1	+2.9
		60			+1°30'	1.6	-18.0
		91			+9°25'	14.6	-1.3
	16	123			+7°40'	16.4	+11.7
16	18	279.9			-0°16'	1.3	13.7
18		62			-5°05'	5.5	12.4
		112			-1°48'	3.5	6.9
		175			-2°03'	6.2	8.9
							6.2

El 1.7
305.1
475.2
336.8
424.5
462.6
461.9
123.5
167.1
340.3
291.0
401.1
539.5
239.6
281.2
279.9
306.3

side slope R 34° L 10' Lower to bottom

toe to River bank 16

toe to River bank from 16

Sta		Dist				Dist	Elev.	
		250			-0°32'	23	10.1	
		340			-1°08'	6.8	5.6	
	0-19	500			-0°26'	3.8	8.6	
19	20	306			+1°48'	9.6	18.2	
20	21	390.5			+0°10'	1.1	19.3	
		168			-1°30'	4.3	22.5	
21	6	60			-7°40'	7.9	11.4	
		140			+0°22'	.9	20.2	+'N old Fowler Road.
	22	213.8			-0°08'	.5	18.8	
22	23	99.1			+0°39'	1.1	19.9	
23		123			-3°50'	6.1	13.8	
		420			+0°31'	3.6	23.7	
	24	469.0			+0°13'	1.8	21.7	
24		43			+6°25'	4.8	26.5	
		262			-0°33'	7.0	14.7	
	25	351.6			+0°48'	4.9	26.6	
25		60.0			0°-0'	0.0	26.6	
	26	312.9			-1°24'	7.6	19.0	
26	26A	211.3			+3°45'	12.8	31.8	
26A		300	st. on	10'	+0°04'	5.0	26.8	
	26B	496+			+8°49'	7.2	34.0	
26B	26C	135.9			+1°08'	2.5	41.5	
26C	26D	179.8			+1°53'	5.9	47.4	
		214.0	from 26	66°52'	-8°35'	31.5	15.9	Iron Pipe S.W. cor. Frantz
26D	26E	148.0			+2°48'	7.2	54.6	

Sta	Dist			Vane	Diff	Elev	
26E	162			-4°07'	11.5	43.1	
	256			-1°33'	6.9	49.1	
	426			-2°0'	14.9	28.7	
26F	601.0			-1°12'	12.6	42.0	
26F 31+	880?			+1°50'	19.0	60.0	
31+ 32a	173.4		S13°14'W S13°45W	+1°34'	4.7	73.7	
32a	80			+0°25'	.6	74.3	
32a	168	18°55R	S31 14'W S32°45W	-0°35'	1.7	72.0	
33a	60	4' Ravine		runs E+W		72.0	
32	94.7	28°14'L	S9°0'W S11°0W	+3°15'	5.3	77.3	
32 26H	121.6	118°52'L	S70°12W	-5°44'	12.2	64.1	
	60	10 deep by 6 deep gully					
33	120	10°38'L	S1°38'E	+3°18'	6.7	84.0	
33 34	78.8			+4°15'	5.8	89.8	
34 35	48.8			+2°40'	2.3	95.6	
35 36	130.7			-0°36'	1.3	97.9	
36 37	184.0			+2°58'	6.6	91.6	
37 38	322.5			+1°0'	5.6	103.2	
38	89			-3°34'	5.5	97.7	
	159			-1°0'	2.8	100.4	
39	~~500~~ 493.7			-1°0'	8.6	94.6	
39	148' back			-6°-32'	16.0	76.0	Bottom of gulley
	70'			+1°05'	1.3	95.9	
	180			-1°1'	2.2	92.4	
	255			-0°20'	1.5	93.1	

Sta	Sta					Elev	
39		360	d on 13' rad	-0°26'	29	84.0	
		450		-0°48'	6.3	88.3	
		660	sight on 7' rad	-1°15'	14.7	78.5	
		~~705~~	sight on 10' "	-1°04'	13.3	76.6	
	40	818.8		-0°42'	10.	84.6	40
40		232	back	-2°30'	10.4	74.2	
		217	forward	-3°0'	11.1	73.2	
		294		-3°45'	19.2	65.4	
	45	498.2		-1°35'	13.8	70.8	45
45		37		-4°42'	3.0	67.8	
	46	227.2		+0°44'	2.9	73.7	46
46		40		-6°0'	4.2	69.5	
		50	10' wide bottom Creek	-7°45'	6.7	69.0	
	47	84.6	off to side	+4°30'	6.8	80.5	
~~46~~ 47	46a	89.1	48.20L S45°E	+1°26'	2.3	76.0	46a
46a	49	222	dot 17'L S62°E	st. on 10' rad +2°26'	9.5	85.5	49
47	50	~~221.2~~		-1°55'	7.4	78.1	50
50	51	90.8		-3°11'	5.5	72.6	51
	52	228.8		-1°30'	6.0	72.1	52
52	53	497.6		-1°25'	12.3	59.8	53
50	54	186.6		-2°28'	8.1	51.7	54
54	55	~~S73.5~~	3°06'R	-6°09'	2.3	49.4	55
56	55a	233.0		-1°52'	11.6	57.0	56
		435	38°41'L 83 on 55	+4°26'	35.2	90.2	
	sideshots	830	55 52	+5°00'	72.1	129.1	
			55°L	+848			

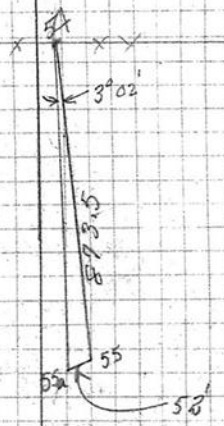

Graig Field 52' SW of 55
ft on W side bridge N of Creek
20's Samsons fuc.
to left of road
~~on road~~ 20's of road
Toward gate near big oak

					Diff. Elev	
56 57	476.8		N84°32'E	+2°16'	18.2	75.2
57.58	382.2		N89°29'E	+0°38'	3.1	78.3
58 58A	968.0	3°-19'R	S87°12'E	+6°29'	8.3	86.6
58B	807.5	32°-57'R	S54°-15'E	+1°23'	19.4	1060
58C	425.3	15°27'R	S38-48E	+1°-45'	13.	119.0
I bar	352.4	121°15R	S83°-27'W	+3°-20'	20.5	139.5
at I'' 62	234.	86°28'R	N10°-05'W	+3°-0'	12.3	121.2

2'W of line fnc betw. Greigs Cor. & Tombs Cor. Set 300' to cr. fnc E of creek 30' in Greigs Fld

Tombs + Greigs Cor. by road. 1812 farther on line

Iron bar near Greigs Bear Treeqpinea

1m wheat below house NE