724

724
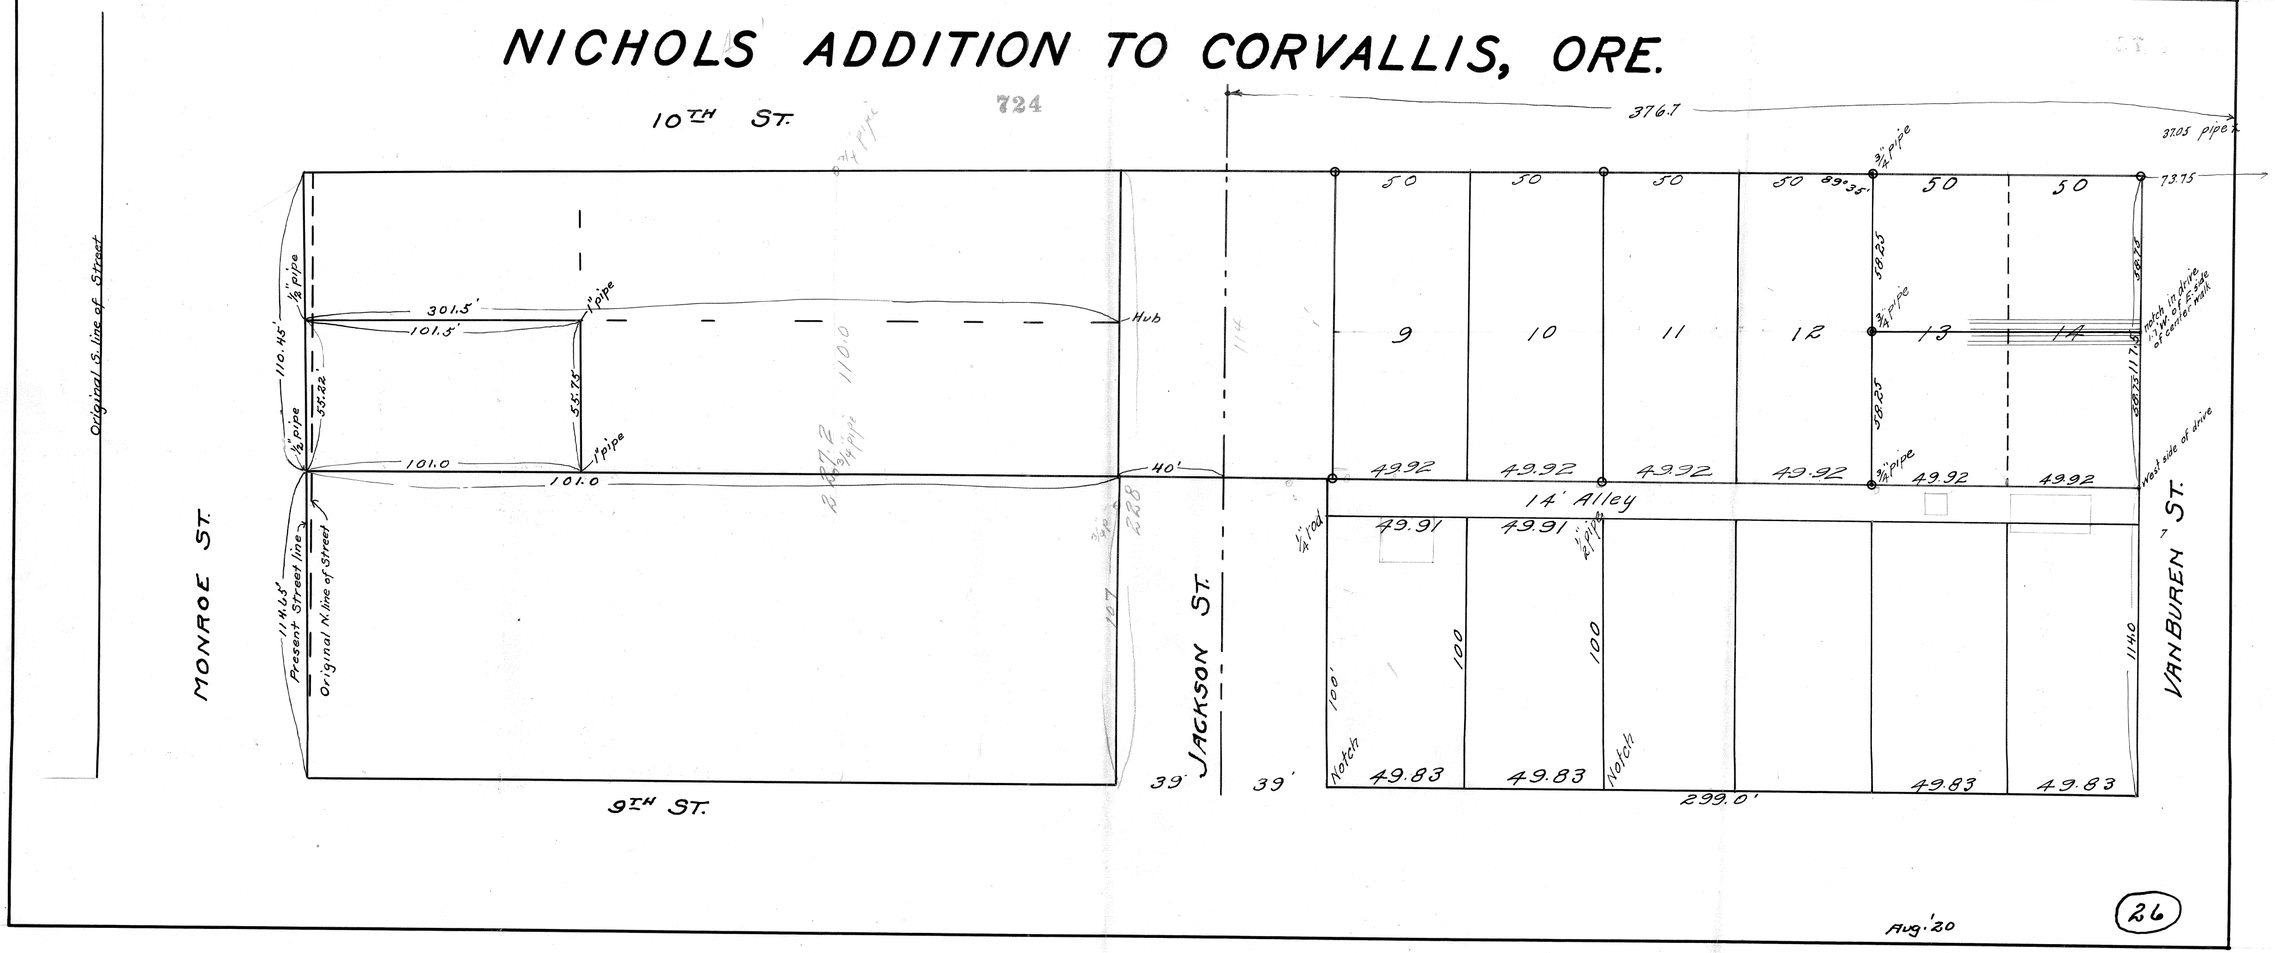
NICHOLS ADDITION TO CORVALLIS, ORE.