C.S. # 725

See notes in file

F.B. 25-29

29 F/B #25, Pg. 29–32

C.S. # 207 #725 J.R. Cain

Begin at 1¼ pipe which is Sec. Cor bet'n 5, 6 7 + 8

Sta.	Dist feet	Dist chs	Def L.	Bear	Mag Br
					N 0° 45' W
0a	Set on hill B.S. on E side of cor post by school yard measured from pipe				
1a	1100-24				
2a	5647-15		2° 15' R		
3a	486.7				
4a					

Aug 25, 1920

Distances in chains

Back to Sta 0 6/7a 1¼ pipe

	Dist	ang	Cal Bt	Mag br.
0	B.S. 3.094 on fnc on hill		+0°4'	N 89° 30' E
0	~~2.25~~ 3.88	0° 20' L		
1	~~3.880~~	2° 27' R	-2°	S 88° 30' E
2	~~5044~~ 5.060	——	-0°05'	S 88° 15' E
3	~~1.322~~ 1.335	——	-0°4' 0"	
4	~~1.760~~ 1.770			S 88° 15' E 7½°
5	3.372 3.410			S 87 45' E -11¼°
6	1.680 1.71	Side shot		S 87 45' E
6 to 7 (6a)	3.953 3.992	0° 55' L		S 89° E -8°
7	0.320	129° 07' L		S 89°
7@				

Aug 21, 1920

Sec 5 T 11–7

℄ Road 6/5 7/8

St up fnc line init ang 89° 29' L

Bear N 88° 43' E or S 88° 43' W

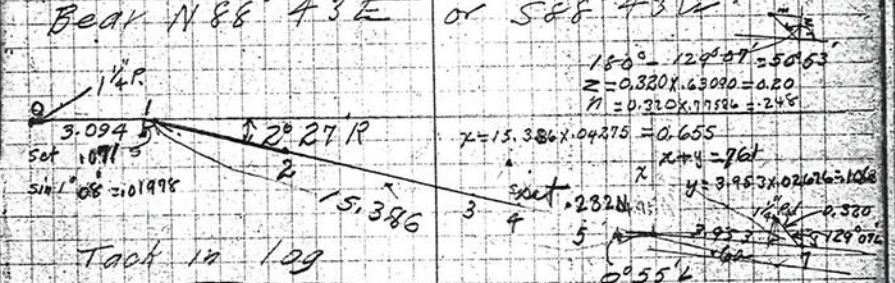

Tack in log

SE Cor 80

Set (6a) 27 W and 265 N

Set point 0.070 opposite old 40 stk. ~~0.07 S~~

Set pt from bear trees.

	Back to Sta 6a BS on 6				
6a	1.668 1.680	91°11'		N15E	+7°
8	1.827	—		N30E	+1°
9	~~1.961~~ ~~1.975~~	—		N30E	+21½'
10	2.415 ~~2.429~~	—		"	+12°
11	1.026 1.029			"	3°
12	3.694 3.695			"	+2°
13	~~6.169~~ ~~6.193~~			"	-3 or 6°
14	1.986 2.061	1°02'R ~~0°56'R~~		N~~65E~~ 15E	+7½
15	1.220	1°02'L		N30E	0°
16	1.513 ~~1.520~~	—		"	-5¾°
17	1.513 1.540	—		"	-10½'
18	4.316 4.320			"	-2°
19	2651 2770	1°24'L		N0°30'W	+15°
20	1.663 ~~1.700~~	0°19'L		N0°45'W	+12°
21	1.186 ~~1.235~~	0°38'R		N15W	+9½'
22	.942 0.948	—		"	+6°
23	2.151 ~~2.185~~	—		"	+1°
24	1.784 1.795	~~91°22'L~~			~~-3°~~
25	5.400	91°22'L		S2E 15E	-20°
26	10.000				0°
27	10.000				
28	9.999 ~~10.000~~				+14½°
28	2.911 ~~3.000~~				14°
29	3.000				0°
40	3.551 4.000				14°

0.07 chs S of old survey stk

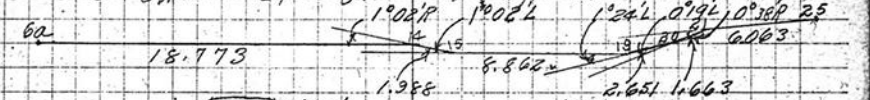

sin (7+15) 1°02' = .01803 sin (20) 0°19' = .00553
sin (9) 1°24' = .02443 sin (21) 0°38' = .01105
y15 = 0.036L y19 = 0.036L y20 = .065+.036=.029R
y21 = .050+.065-.036=.079R
y25 = .115+.079=.194R

117 0.70 parallel fence

near logging road

S side of canyon near 6' snag
N " "

Set (25) N 230

R. in ℄ Private road

To 40 fnc

	3.680				
41	3.70				+6°
42	3.920				-23°
	4.00				
43	10.0				0
44	3.084				+25°
	3.30				
45	1.00				0°
46	0.956				-17°
	1.00				
47	6.31				+20°?
	6.64				
48	Total dist = 61.111 chs				
	Back to 25 - B.S. on 23+24				
	1.074				
25	1.170	86°28L		N86 3/4W	+23 1/2°
	3.100				
26	3.150	0°12R		N86 36W	+10 1/2°
27	0.867	—		"	0°
	3.305				
28	3.360	7°0'L		S86 45W	-10°
	3.096			89°	
29	3.048	3°43R		S45'W	+3°
30	2.968	—		"	0°
	2.120				
31	2.145	—		S89 45W	+9°
	2.160				
32	2.188	1°30R		S88°15W	-8 1/4°
	3.097				
33	3.540	sideshot		S88°W	-30°20'
34					
	1.468				
33-35	1.83				-36°40

over

S 1/4.

1/4 sec cor found Ost. S89°W.
Old cor. tree 1's .223 N 31°45 E
89° 39' Int. all to tree on line
by 1/4 sec cor betw 4+5 Mag. S89 30'W

Set Fir 11 in.
B.T. 30" Fir > 88°E .37 Dead.
36" " ? N 30°W .61

E side Co Road

℄ bear tree 0.010 to N of Center
dist. to 1¼" rod St. on ℄ near BT.
B.T. 16" Fir S 5°W 2.67
30" " S 84°W 10.96 MM

3.3 Links E of ℄ Br tree		BS on (3 3)		
36	5.752	94° 35′	S3°E	
37	5	4°168	S2°W	
3a				

set 80 cor mar 6a
3 x 3" fir stake
6" Maple bears S 63°15′ W 0.720
30" Fir bears N 22°45′ W 1.210

Pd. $105.50

3.3 links E + 1 link N of ℄ Br tree.
1S sta 4a in first day's survey