C.S. # 730

Hardcopy 14-8 #5

also see notes in file

F. B. 25-69

69

Sec 13, T 14 S R 8 W CS 730 F/B 25, PG. 69-70

Copy of Survey #275 cont.

#730

Nov. 3, 1920

For. Ira Walker c.h.

Lester " axe

Sam Bowen —"—

Bill Steprow —"—

Began at 1½" shaft on S.W. cor. Sec 13

Sta				
1	10.07	N 0° 19' W	hit .265	
2	7.914	"	W of cor.	
3	2.590	4° 10' L N 4° 29' W		
20 cor.	20.59	To ¼ cor betw 13 & 14		
		Tan 4° 10' = 0.72885		
		259		
		.189		
		.265 - .189 = .076		
½ 40 2A	1 bar	set ② N. 217 and E. 038		
		correct E 0° 13'		
		(N 0° 06' W)		

Back to 2A BS on 1

2A	3.977	90° 13' R	N 89° 54' E		
5	14.657		(correct S 0° 17')	set S. 02	+16½°
	4.742		= (S 89° 47' E)		
more road	1.3781			set S. 064	+10°
6	13.535				
	4.913				+18°
7	5.143			set S. 06	
8	2.204	2° 13' R	S 87° 53' E	set S 14	+17°
	2.40				
	2.574				
9	2.60			set S 02	+8°
10	10.193	90° 32' R	S 2° 53' W	set 15.004 V .08	-7½
	10.685				
11	1.159	89° 30' R	(correct S 0° 19' E)		-13
	1.19		= (S 0° 34' W		
12	Yew Stk 13/24				

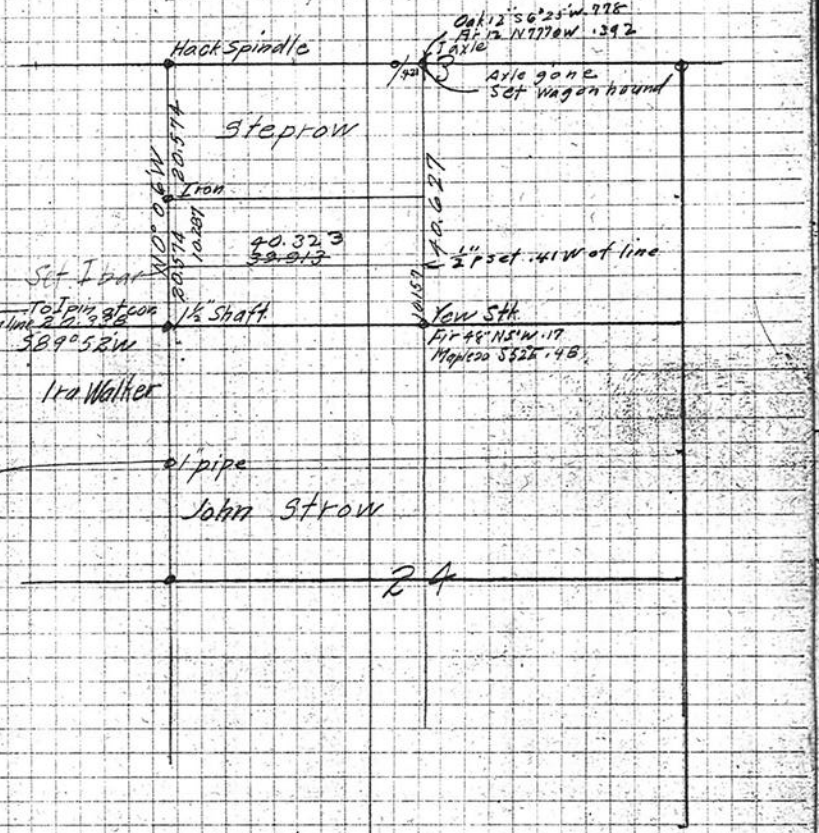

Set ½" pipe
Fir 40" NE. 10 to ℄ E & W

Note:— pipe was set .41 too far W due to error in calculations.

Total Dist = 41.893
betw cor = 41.893 - 1.93 = 39.913
= 41.893 - 1.570 = 40.323

	Back 3076	to 10	BS on 11	
10	~~3.333~~			+22° 50'
11 Top H.11	1.585 51			+12° —
12	1.374			0 c
13	3.818 (3.85)	is included in total to pt Near 40 cor		-7° 10'
near 40 cor	12.035			-2 ½°
14	7.976			- 8 ¾°
	8.072			
15	2.643			- 6 ¼°
	~~2.86~~			

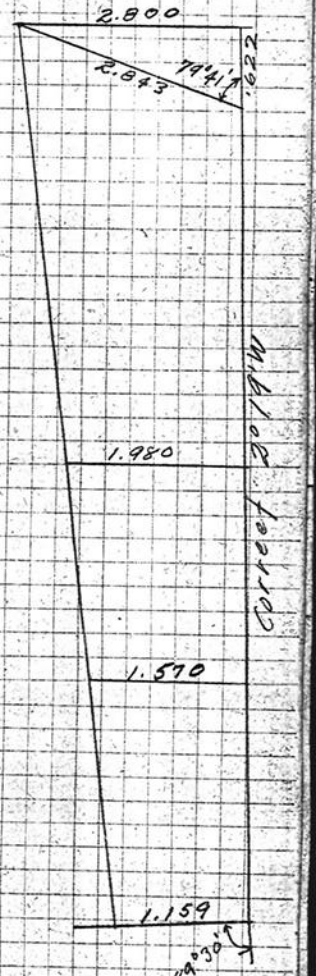

14" B.T. Oak S12°35'E, 39

6 2 2
7 9 7 6
1 2 0 3 2
3 8 1 8
1 3 7 4
1 5 5 1
3 0 7 6
3 0 4 4 9
1 0 1 5 7
2 | 4 0 6 0 6
2 | 2 0 3 0 3
1 0 1 5 2