C.S. # 735

in

Willamettedale Farms

Sub.

F.B. 25-48

48 FB# 25 Willamettedale Farm

C.S. # 96 cont. for Faulkner

#735 Began at 3/4" pipe at the intersection of ℄ of Albany-Corvallis and side road; run line thru 3/4 pipe S 32° 15 E in ℄ A & B road to 3/4 pipe in ℄ of road which is S.E. cor of tract in Willamette

Run S. 89° 38' W 5.282 chs set 3/4 pipe, thence N 0° 22' W 6.726 chs, set 3/4 pipe, thence N 89° 38 E 9.584 chs set 3/4 pipe, thee S 32° 15' W to S.E. cor of 5A Tract

Measurements checked very closely. Pipes in road slightly out of line.

Approx. Location 24 | 19 / 25 | 30

Tracts 5A tract sold by Faulkner

Sec 25 I 11 - 5 / Sec 30 T 11 - 4

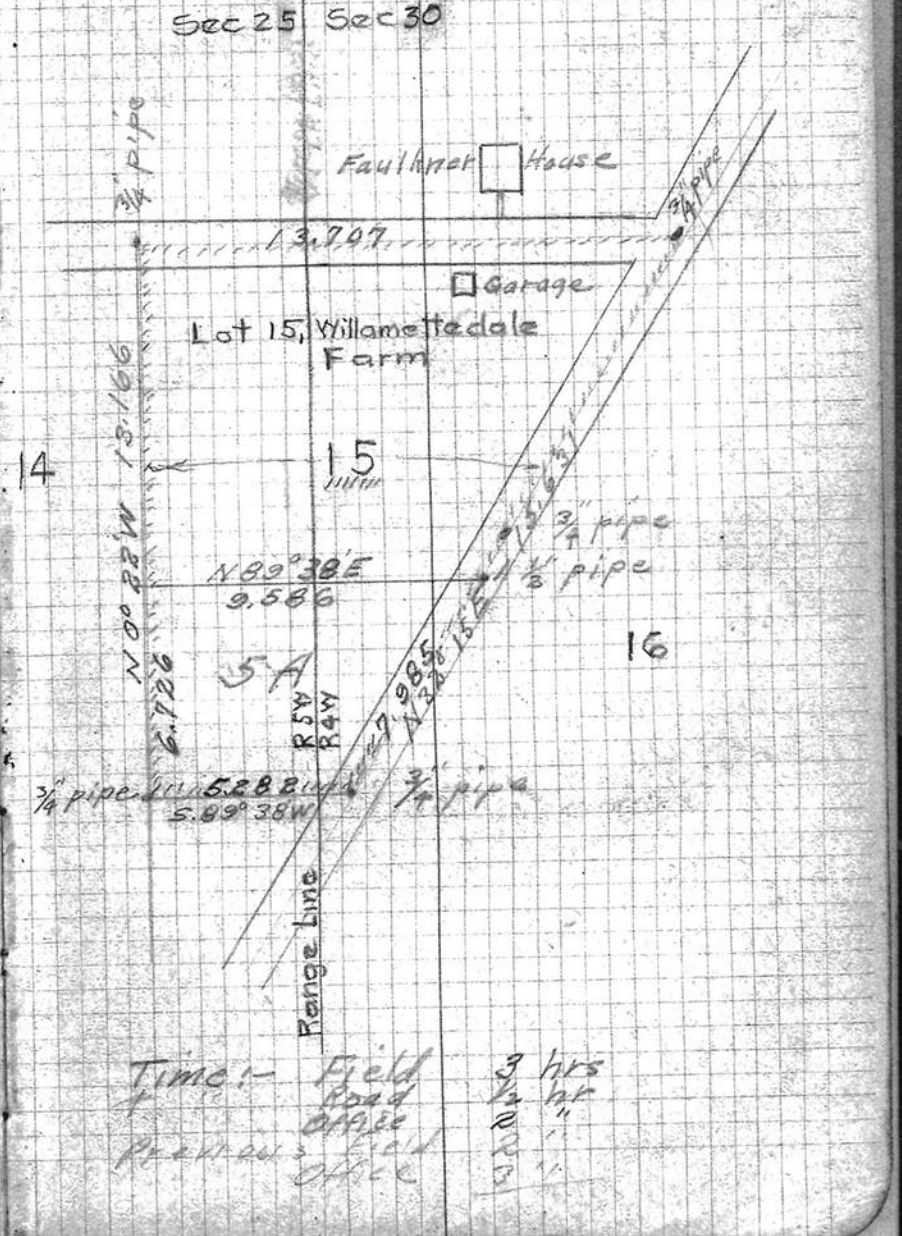

Time:- Field 3 hrs
Road 1/2 hr
Office 2 "
Return to field 2 "
Office