C.S. # 739

Hardcopy 13-6 # 3

also see notes in file

F. B. 25-62

62
F/B 25, pg 62-63

Sec 9 + 10

#739 T 13S R 6W Dec 21, 1920

C.S. 308 For Hugo Newman

Began at 1/4 cor N sec 9

0				offset
	-4°30'			
	1.255	1.251	N89°12'E	
1	-6°30'		Correct S 1°02'	5.0225
	3.590	3.567	= S 89°46 E	
2	-2°20'			.0866
	5.00	4.995	90 ft	
	-2°20'			
	1.112	1.111	20 ft	
3	-6°15'			
	5.000	4.970	100 ft	.1966
	1.480	1.480	30 ft	
4	-5°45'			.3126
	4.999	4.974		
5	-5°45'			.4019
	3.218	3.202		
6				.4594
	1.430	1.430		
7	-5°15'			.4851
	5.000	4.979	100 ft	
	1.403	1.403	28 ft	
8	-7°10'			.6001
	7.747	7.687		
Sta opposite Sec Cor 9	-7°40'		S 89°54' E	
	5.620	5.620	1°54' R S 88°54' E	
10			Correct S 43°45' E	
			= S 88°56 E	

N 89°12' E
1.54
90.06

Found Oak standing
" fir stump.
Set stk (Oak)
6" Chincop. N 87°30' E. 25

1.251	0.0225	①
3.567	.0641	
4.995	.0866	②
1.111	.1100	
4.970	.1966	③
1.480	.1160	
4.474	.3126	④
3.202	.0893	
	.4019	⑤
1.430	.0573	
4.979	.4594	⑥
1.403	.0257	1600'
	.4851	⑦ 13E
	.1150	
	.6001	⑧ .7 38 ⑨
7.687	0.0180	= 1°02'
41.049	.73700	
+.022	41049	
41.071	326510	
	32 8392	

.0294 x .737 = .0216

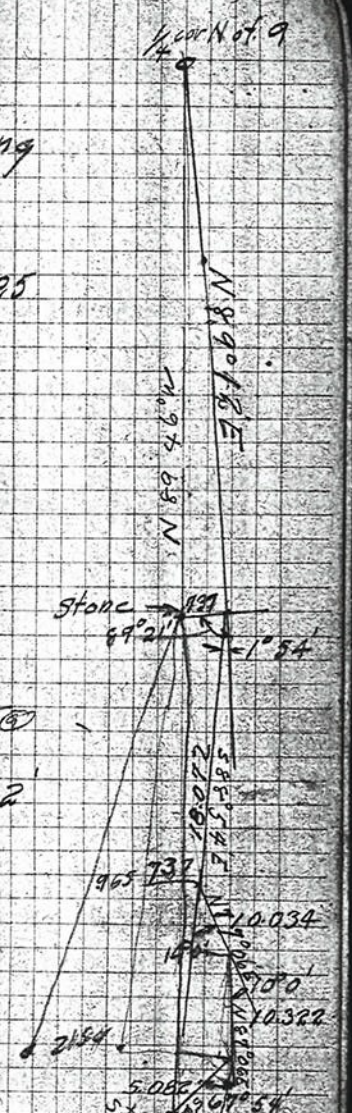

Set 5/8 rbl
S 89° 21' E 737 ft of NE cor Sec 9
Oak 2" alt North .24
Oak 4" " N 45° E 4.50
Set

63

10

-4°0'

12.482 12.452

N.228

-2°30'
5.06
+4°30'
5.054
} 10.034 14°0'Z N76°06E

+00'R

10.067
+.255
} 10.322 14°0'R N86°06E

+5°15'
5.103 5.062 67°54'R S26°06E +0 →

18.072
9.730
10.297
2.236
40.341
-.022
2 | 40.319
40.374

Rebar 1/4 cor N Sec 10 set 10"x12"x8" marking typ
Oak 30" N56°E 3.370 Stand
Fir 16" N24°45' W. 1.662 SA

.03542
40.319 | 1.41700
= 2°01'S

N 2.427
N .720
3.147
S 4.564
S 1.417
.737
= 3°04'

.0632S
.329
.961

40.019 | 2.1540 .05338
201595
138050
122457
155930
122427
33503

S .737
N .302
S 1.439

S .965
S .737
N. 228
S 1.702