C.S. 749

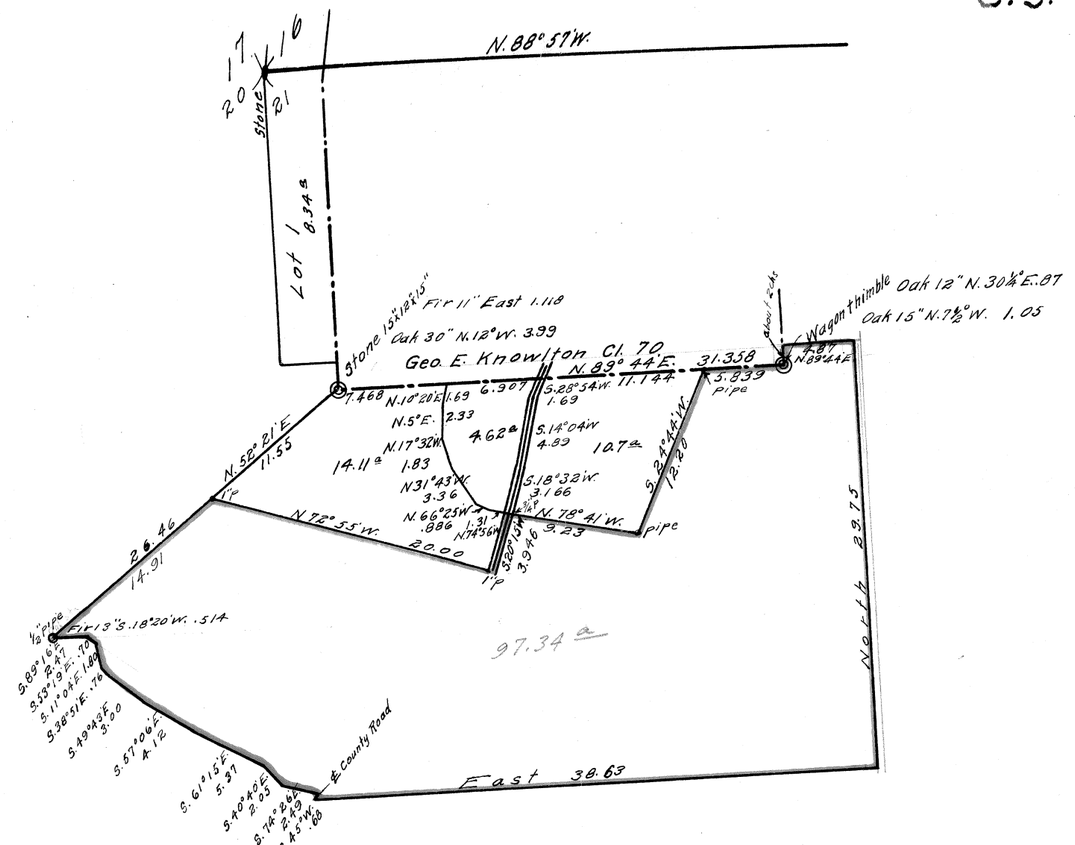
N. 88° 57' W.
17
16
20
21
Stone
Lot 1
8.34 a
Stone 15"12"15"
Fir 11" East 1.118
Oak 30" N. 12° W. 3.99
Geo. E. Knowlton Cl. 70
N. 89° 44' E.
31.358
Wagon thimble
Oak 12" N. 30¼° E. .87
Oak 15" N. 7½° W. 1.05
N. 89° 44' E.
S. 89° 44' W.
13.20
pipe
North 39.75
East 38.63
County Road
97.34 a
Fir 13" S. 18° 20' W. .514
½" pipe
N. 52° 21' E.
11.55
26.46
14.91
N. 72° 55' W.
20.00
N. 78° 41' W.
3.23
N. 17° 32' W.
1.83
14.11 a
4.62 a
10.7 a
N. 5° E.
2.33
N. 10° 20' E. 1.69
6.907
S. 28° 54' W. 11.144
1.69
S. 14° 04' W.
4.89
S. 18° 32' W.
3.166
N. 31° 43' W.
3.36
N. 66° 25' W.
.886
N. 14° 56' W.
3.946

C.S. 749

F/B 28, Pg. 30-32

30

#749

C.S. #71 Continued

Beg. at the S.W. cor. of Geo. E. Knowlton Cl. 70 7 12-6

Offset S. at Lots. .142

Thence	East		
1		-4°35'	4.138
2		-6°05'	7.918
3		-13°30'	5.418
4			7.661
5		+4°40'	4.764
6		+5°20	1.682
			+.001
	Striking S. of cor.		.146

S. S.E. of Cl. 70

Back to △ 4 Set N. 145

7	East on line		.592
8	S. 25° W.		1.756
9			5.259
10			3.578
11			.925 Nail in stump
12			.670
13			.012
	Set stake		
14	N. 78° 25' W.		9.244

To ⊙ 1.307' N. 84°45' E. from Oak

Witness tree; S.E. cor. of Cemetery.

-.013 To line at 0.084 N. 18°48' E. of S.E. of Cemetery.
-.016 To line at 0.084 N. 17°54' E.
1 Pin ought to be N. 18°48' E. .219

Mar. 1, 1921. Clarence Wood

			4125
			7.873
			5.268
			7.661
			24.927
			4.748
			1.682
			.001
			31.358

			.592
			1.756
			5.259
			3.578
			.925
			.670
			.012
			12.200

24.927 + .592 = 25.519

24.927 + .592 = 25.519

24.927 − 14.372 To ℄ road = 10.555 + .592 = 11.147

24.927 − 7.661 = 17.266

17°54' − 17°23' = 31'

Set stake on line E. .303 of S.E. of Cemetery.

+10°55' 29C

Ott's K = 2.904 + .017 N. 143

31

correction W. 13'

thence 15 S. 20°18' W. 4.027 along ℄ of road.

Back to Beg. or S.W. of Cl. 70

thence 16 S. 52°27' W. 11.570

correction 10' N. (S. 52° 37' W.)

+.020 N.035 .036 S.W. of cor. +.017 to distance

Set stake to be replaced by 1" g. pipe.

17	S. 72°40' E	-5°35'	4.455	
	correction 3' (S. 72°37' E.)			
18		-8°30'	7.958	
19		-2°30'	6.214	
20	∠ Left 42'	-12°54'	1.497	offset .018

To ⊙ in Cen. of road

Set stick to be replaced by 1" galv. pipe

N. 72° 42' W. .300

to △ 14	N. 20°18' E.		4.027	-N 17°54' E. -226 to 3/4" pipe
From △ 14	S. 17° 54' W.		.084	S.E. cor. of Cemetery
21	N 74° 40' W		1.315	-005 = 1.310
22	N. 68° 11' W.	+3°30'	1.881	-.004 9 N.E.

correction 2° 2' E. (N. 66° 09' W. 3.76)

Orig. stake -.004

& .031 N.E. & stake

23	N. 31° 07½' W.	+6°5'	-.005 + S.W. .026 3.388	

correction 19½' W. (N. 31° 27' W. 3364)

W. .007 from orig. stake

S. .002 + .007 W. from

24	N. 17° 15 W.	+3°30'	1.835	

(N. 17° 15' W. 1825)

+.002 +E. .007 no stake

25	N. 5° 00' E.	6°20'	2.350	-.001 + W. .007 -.002 + E. .018 c/d stake

correction 16' E.

W. .018 or To cor. of Cemetery

26	N. 11° 13' E.	+2°30'	1.689	rite.

correction 37' W.

N. 63°22' W. to △ 1

N. 89° 57' W. to △ 0

4.027 .002 4.029 .091 3.938 S. 20°5' W. .310 .219 .091

continued +1°30' 5.004

-1° 7.195

2.694

26400 / 23.766 = 2694

offsets .036 S.W. .018 NE. .018 S.W.

19.95 .00075 E 3' .0180

[5.18° 48' W. S. 17° 54' W. 54']

(found stake + replaced with Oak 20 N. 7°08' E. 3.859 12" S. 76°26' W. 1.424)

11.570 5.002 7.194 23.766

.017 4.434 7.871 6.208 1.459 19.989

.879 .004 .875 .001 N. 66° 09' W. .876

3369 .005 N. 31°27' W. 3.364

(Beg. is N. 74° 40' W. or 174° 37' W. " " N. 68° 11' W. " " N. 31° 07½' W.)

offsets .026 W. .007 E. to stake .019 W. = 19½'

offsets .018 E. .007 N. .011 E.

1.825 .002 1.823 .002 N. 17° 16' W. 1.825

2.336 .003 N. 5° 16' E. 2.333

N. 10° 36' E. 1.687

32

From △16

27	S. 52°27'W.	+1°30'	5,004	
	correction N. 10'	-10	7.195	
28			2,694	
29			.074	

Set pipe N.
Did not find oak stake so measured 30' N. at Lots to line and set ½" galv. pipe from which Fir 13" S. 18°20' W. .514

.00299 = 10'

20.46) .07900
5292
26080
23814
2266

11,55
992
2310
10395
103
.03452

11,570
5002
7.194
2,694
26.460
11.57
10.91
4.92
29.82
13.41
1.74
.01157
.035
.277