752

752

10-3

31

752

COUNTY SURVEY #277

John Q. Thornton D.L.C. 37, Sec. 31, T. 10-3.

Scale 1" = 4 chns.

W. C. Galloway C.S.

March 22, 1921

752

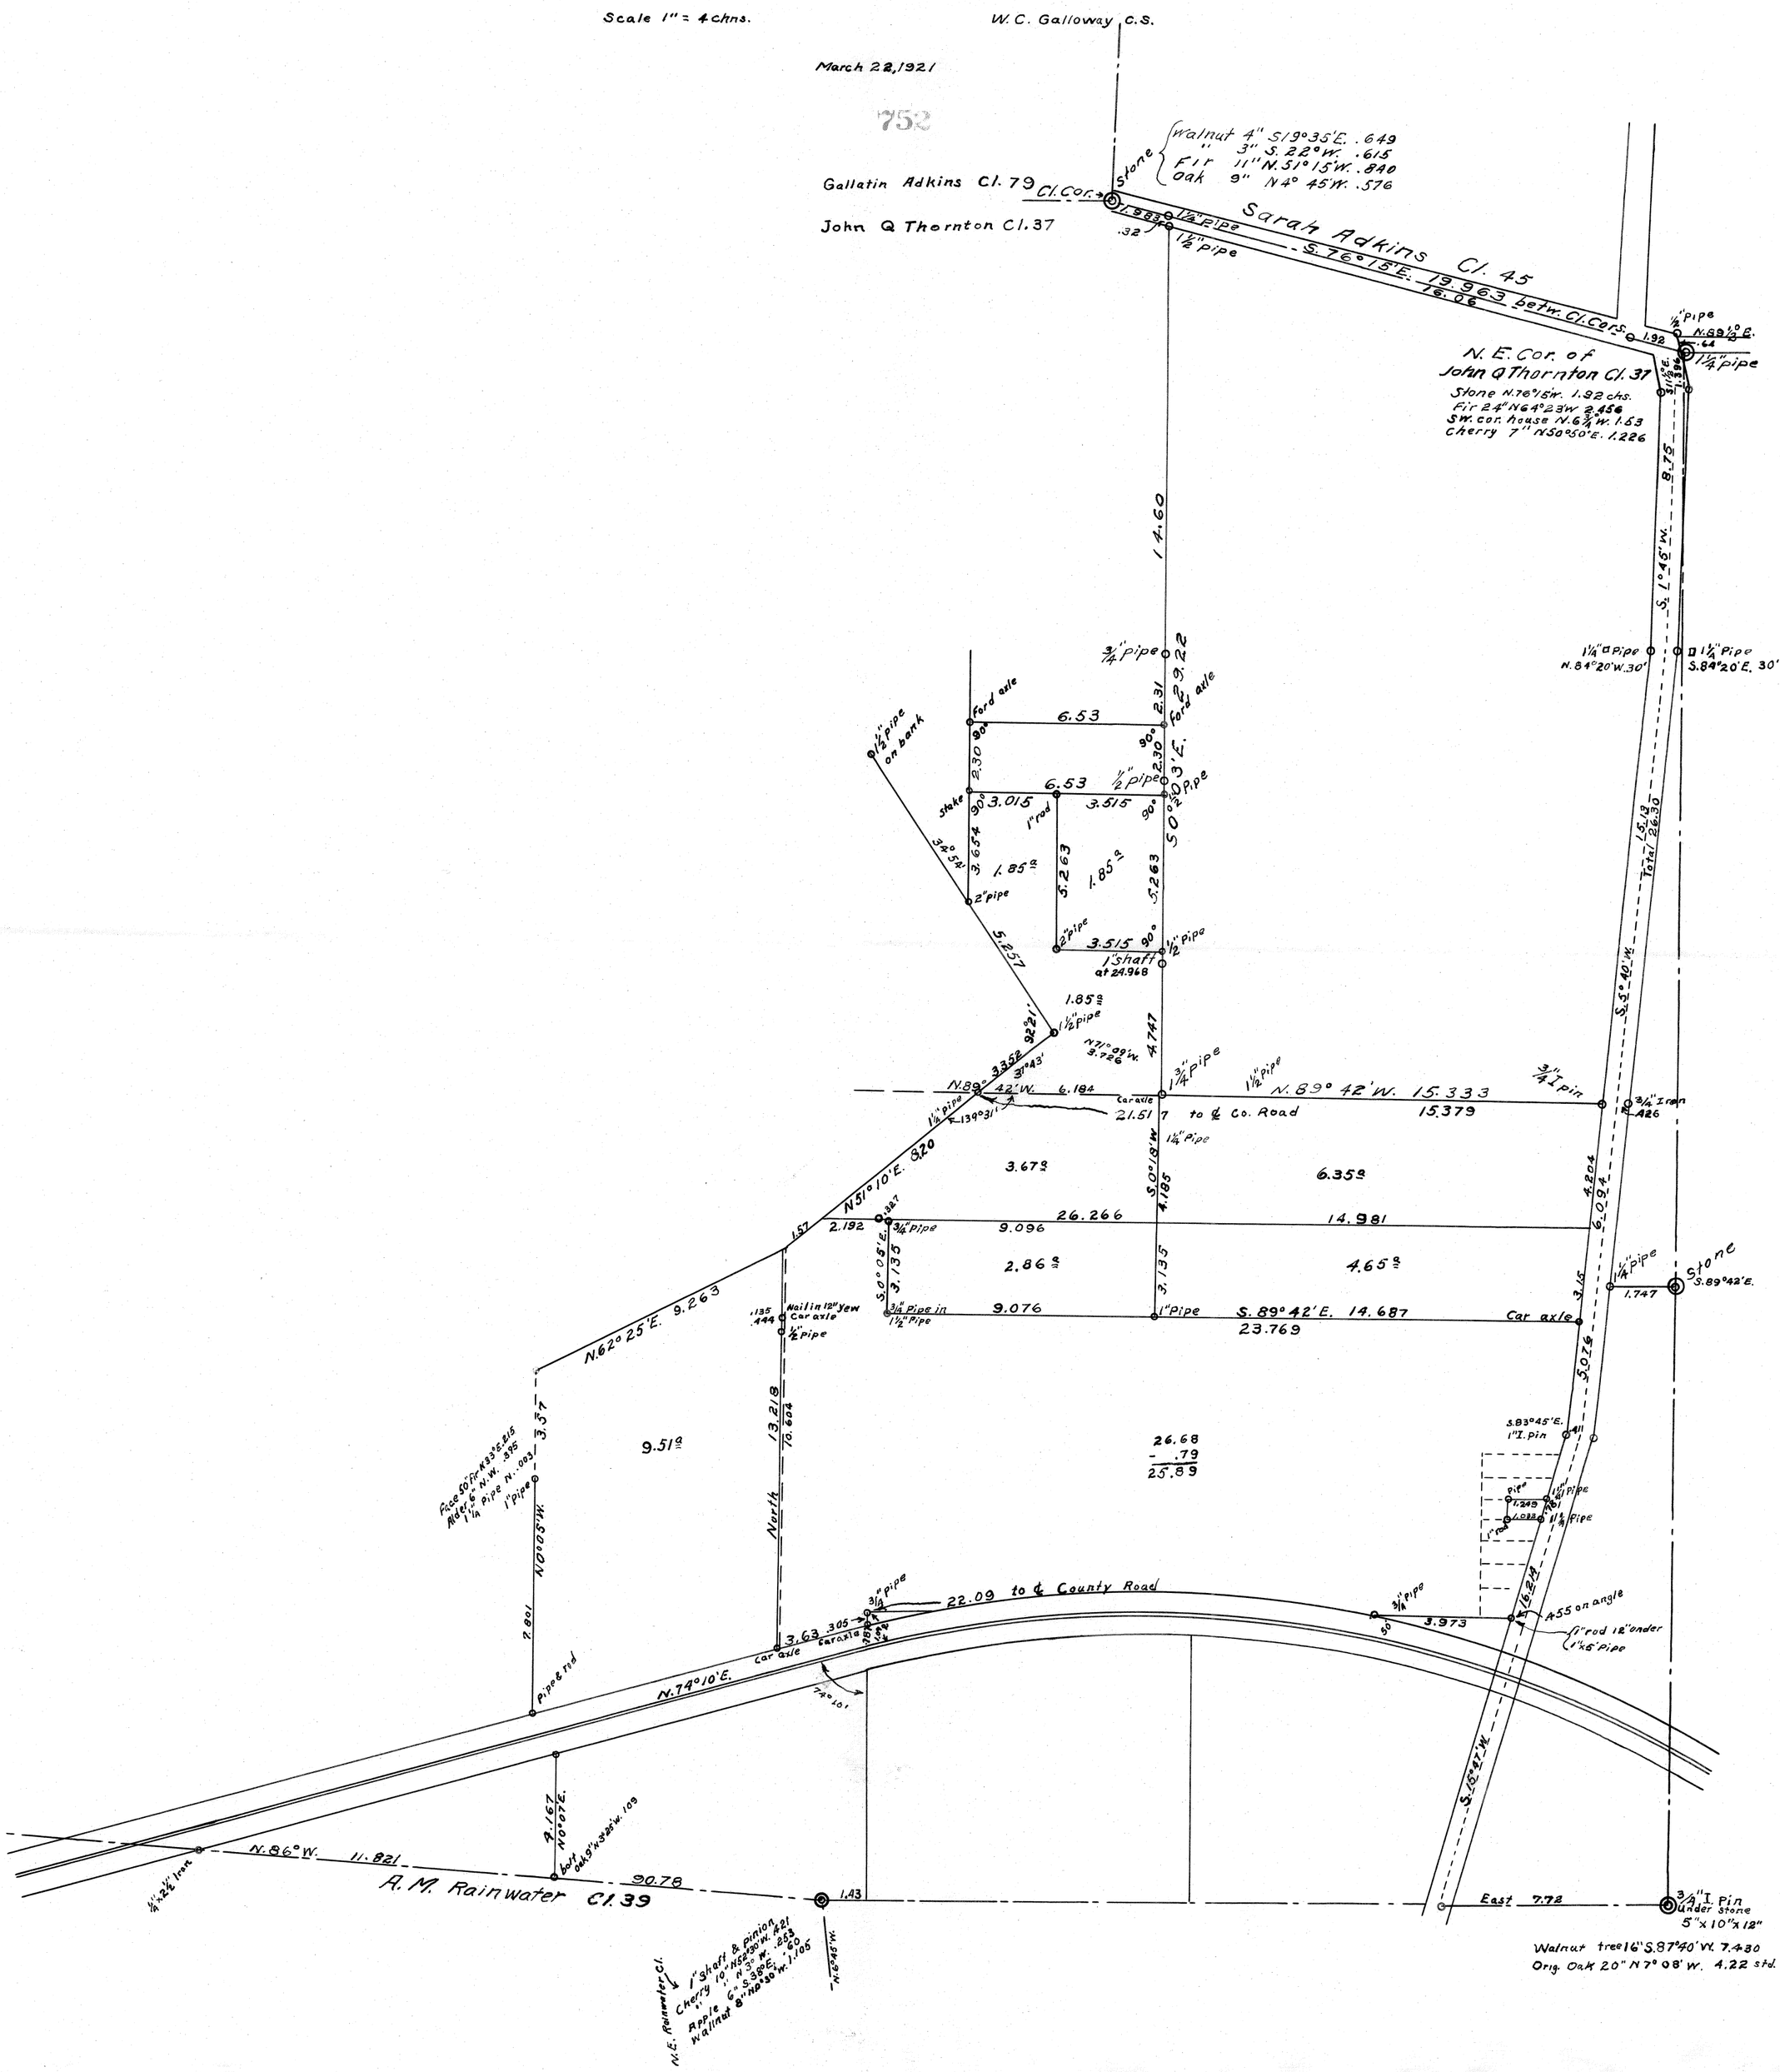

36 FB#28

#752

Recorded C.S. #277

S.E. of Gallatin Adkins Cl. 79 T. 10-3

Stone 6"x6"x? Set

Walnut 4" S. 19° E. .649 cks.

" 3" S. 2° 15' W. .615 "

Fir 11" N 51° 15' W. .840 "

Oak 9" N. 4° W. .576 "

S. 75° 45' E. on claim line 510

1		18.043	S. line of Newmans E.
2		1.280	set nail
3	S. 1° E.	1.400	
4	S. 2° 15' W.	8.750	
5	S 5° 40' W. correction W. 24' (S. 6° 04' W.)	6.754	
6		5.772	-1°30'
7		2.606	
8		6.110	
9		5.060	Moved W. at Lts. .188
10	S. 16° W. correction W. 24'	8.000	offset 304 W. to 3/4" I pin
11	∠ Right 2° 06'	8.308	
	Walnut tree 16" S.E.	.375	
Rec'd t.l.	East	7.720	
J.D. Thornton S.E.	Set 3/4" I pin	in field 10" under surface	under S. Stone 5"x10" 3/4
	Walnut Tree 16" S. 88° 10' W.	7.430 cks.	
	Oak 20" N. 7° W.	4.22	.324

Elev. of top step on School house 203.5

For Vance Estate 18 F Hughson

March 14, 1921. Sunshine

F. Rept.

N.E. of J.Q. Thornton Cl. 37.

Set 1/2" □ pipe

Ground Stone N. 75° 45' W. 1.92

F. 24" N 63° 53' W. 2.456 cks.

S.W. cor. House N. 6° 15' W. 1.530 "

Cherry 7" N. 50° 20' E. 1.226 "

at Mail boxes.

+1.92 set Reg. N.E. of J.Q. Thornton

18.043
1.920
19.963

7.720
5.548
2.172
.500
1.672

5.042
.789
45738
4063
355
50158

15.130
6.089
21.219

15.130
12.524
2.606

6.754
5.770
12.524
2.606
6.110
21.240
5.060
26.300

Cl. cor. 0.7
Tp. line
.041

10.764
4.673
6.091

Move I. pin N. 066 E. W. at Lts. .068

8.308
4663
24924
4984
498
33
.30439

Move Cl. cor. S. 83° W. .047

16.300
.033
16.273

37

Back to △7 corrected

				Set ¾" I pipe
TAS.	13	West correction N. 48'	12.570	Y. 174
	14	(N. 89° 12' W.)	1.253	N. 191
			1.536	
		Set 1¾" pipe N.	.213	
		Back to SE. cor.° of Gallatin Adkins Cl.		
	15	S. 75° 45' E.	1.983	
		Set 1¼" galv. pipe	set 1¾" pipe S. .32	
	16	South correction W. 27'	5.726	
	17		4.189	
	18		4.685	
		Striking E. of cor.	.116	
		Set ¾" pipe by post		
	19		4.242	set ¾ pipe W. .150
	20		5531	
	21		.595	set 1" shaft W. .198
	22		3.801	
	23		.661	
			-.210	
		Set 1¾" pipe	.232	
		S. 6° 04' W.	6.089	From ⊙ near △7 to S of
		Set 1¼" pipe S. 89° 12' E. .455	+.037 = .492	

: S. 89° 12' E. .40 + .026 which makes it N. .002
N. 89° 12' W. .455

.00794 = 27'
14.6) .1160
1022
1380
1324
660

1304
232
1536

.01387 = 48'
15.36) .2130
1536
5940
4608
13320
12288
1032

16.860
13823
3.037

1686
1437
1.50

12.570
1.253
13823
1.536
15.359

5726
4.189
9915
4.685
14.600
4.242
5.531
.595
3.801
28.769
.661
29.430
.210
29.220

14.60
9915
4.685

about — 4.242
Set ½" pipe

29.220
28.769
.451

28.769
3.801
24.968
24.9

N. 89° 51' W.

S. 89° 19' E. to Cl. cor.

Hughson's