C.S. # 753

Wells and McElroy

Block 28

F.B. 28-41

Field Book 28

MINING

TRANSIT BOOK

368

Miscellaneous

Block 41 Wells & McElroy's Add.

For John Piper to Archie Pickard

#753

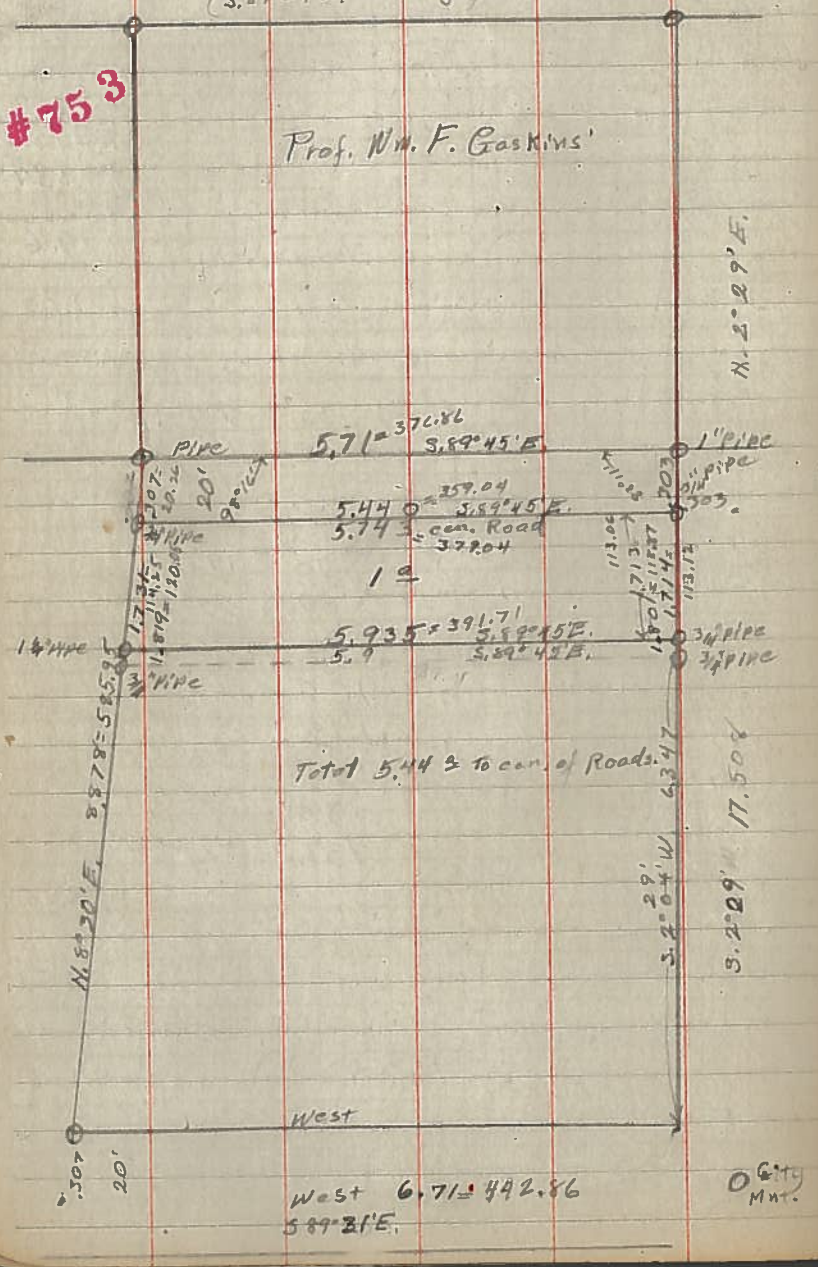

Plat Book 2-1. D.R. 74-385

2029.7
2044.
25.4

	N	S	E	W
	8.781		1.312	
		.025	5.710	
		8.748		.316
				6.710
	8.781	8.773	7.022	7.026
	2.016		.301	
		.025	5.710	
		2.017		.073
	.026			5.935
	2.042	2.042	6.011	6.008

1731
.307
2.038
1744
.303
2.017

8.878
.307
8.571
1.819
6.752

8.754
.303
8.451
.303
8.148
1.801
6.347