C.S. # 760

Hardcopy 10-6 # 19

also see notes in file

F. B. 29-23

23 #760 F/B 29, PG. 23
CS 760

CS. 276 con. Sec. 30, T10S, R6W.

Began at I pin & road

5.499

1.800

96.6

2.456

44° 11'
33.6

.71

3.366
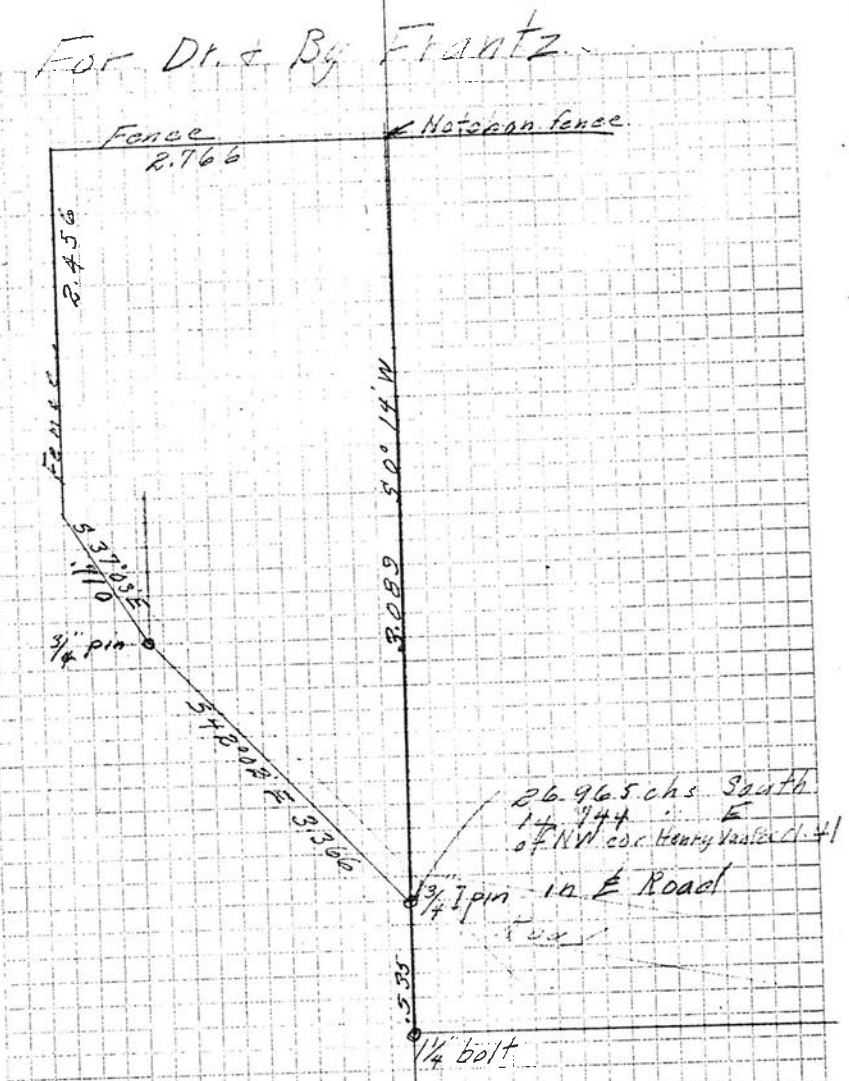
For Dr. & Bg Frantz.