C.S. # 763

Fairview Addition Supp.

F.B. 29-30

30 #763 FB#29

Survey for Gilkey-Corvallis
Betw. Jackson & Johnson Sts.
& 30th & 31st

Found ¾" pipe at intersection of West line of tract with Jackson St. Replaced with a 2"x36" galvanized iron pipe & reset ¾" pipe inside. Found ¾" pipe at NE cor. Str. interseection 31st & Jackson. Measured W. 25' and S. 20' set transit, backsight on ¾" pipe 31st & Harrison; backsight on ℄ Jackson St. E.; shifted to center and set ¾" pipe for intersection of 31st & Jackson. Set block corners 20' S & 25' E & W of ℄, produced ℄ of 31st St. to S side of tract. set hub. Set lot corners on W side of tract on S side. Set corners on W of 31st on E of 31st, and 100 farther E set lot corners as shown on plat. Checked to sidewalk on 30th St. and adjusted line to fit.

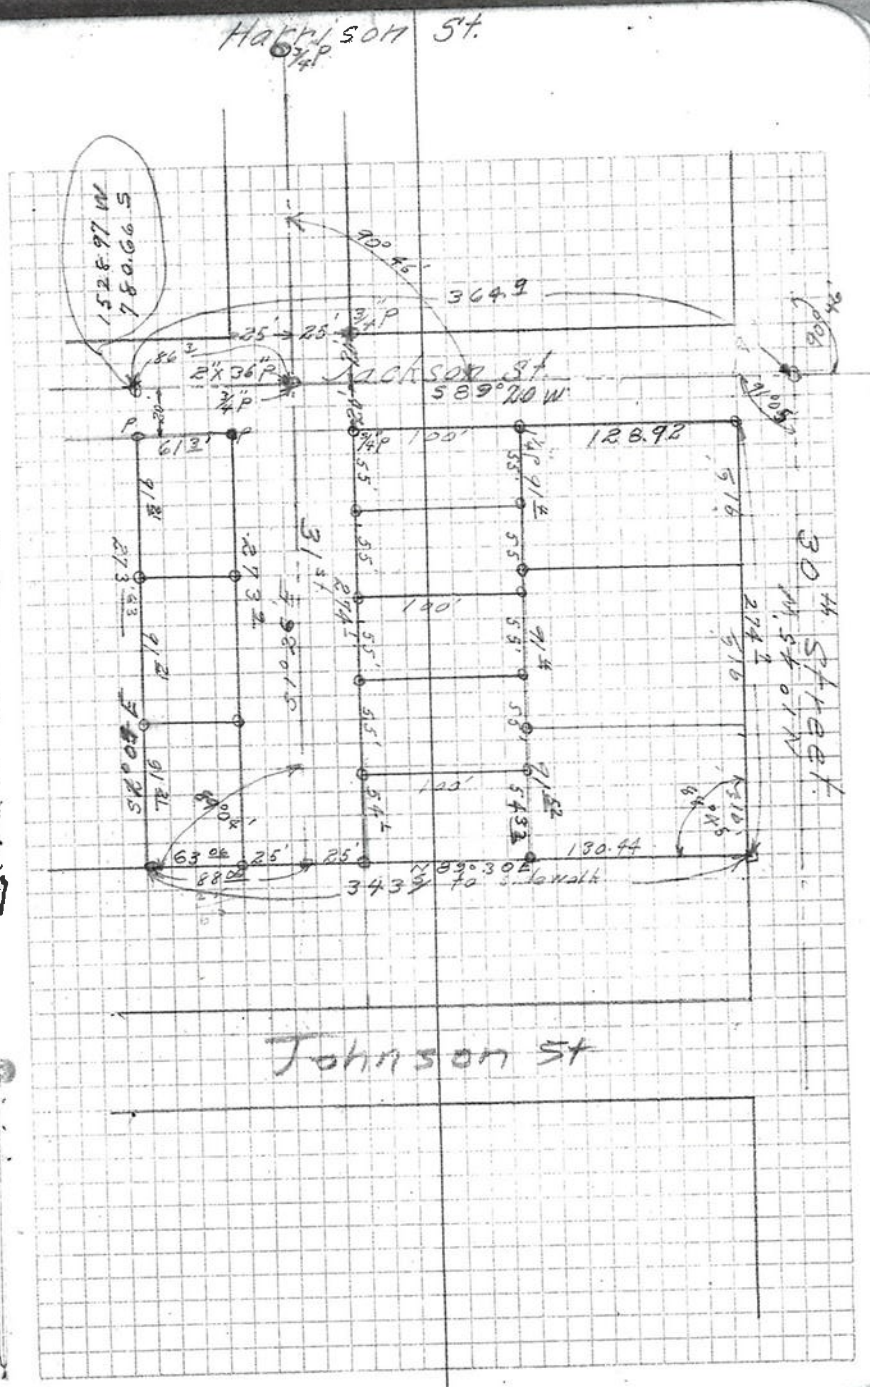
Harrison St.
Jackson St.
S 89° 20 W
364.9
128.92
130.44
343.7
to Sidewalk
30th St.
Johnson St
31st
2"x36" P
¾" P
61.32'
91.81'
91.74'
63.04'
88.02'
