C.S. # 764

See notes in file

F.B. 29-32

31 #764 C.S. 764 F/B # 29, Pg. 31-32

C.S. 195 con.

Survey For Whiteside Brothers

J.C. Alexander Estate in Lilly Estate

D.L.C. 46, T. 12 S R5W

Set ¾" pipe opposite old backsight on fence on E side of Highway & in line with pipe by Lincoln School and one on N side of D.L.C. 46. 40 ft. from ℄ Road. Measured N dist for ½ width of tract, then for full width found pipe in ℄ road. - did not quite line up. Went to E end of tract found pipes at corners measured ½ dist for ℄ private road set pipes 15 ft. each side set up backsights and run in lines as shown in sketch.

Preliminary Survey

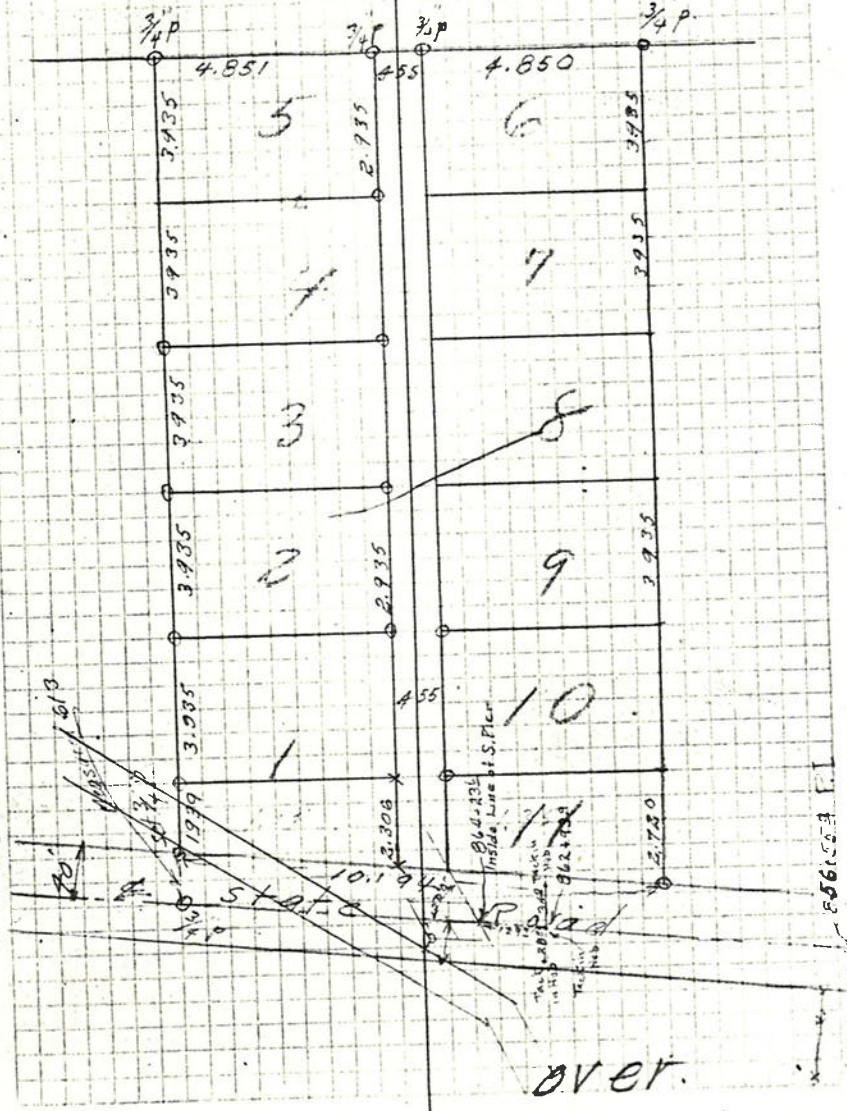

Survey For Whiteside Brothers in Lilly Est 7/19-5

Width of roadway was changed from 30' to 40', pipes being set over with tape drawn over pipes already set. First pipes pulled. A 2"x36" pipe replaced the 3/4"p on S.E. corner.
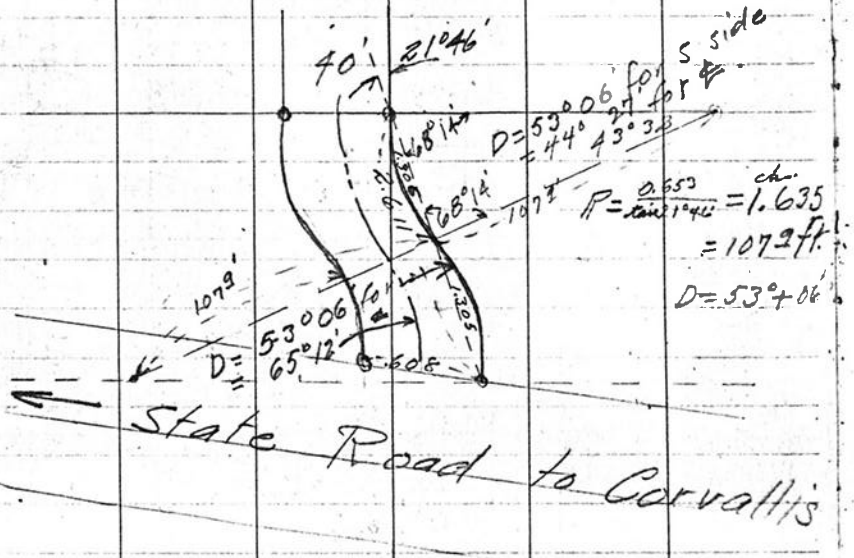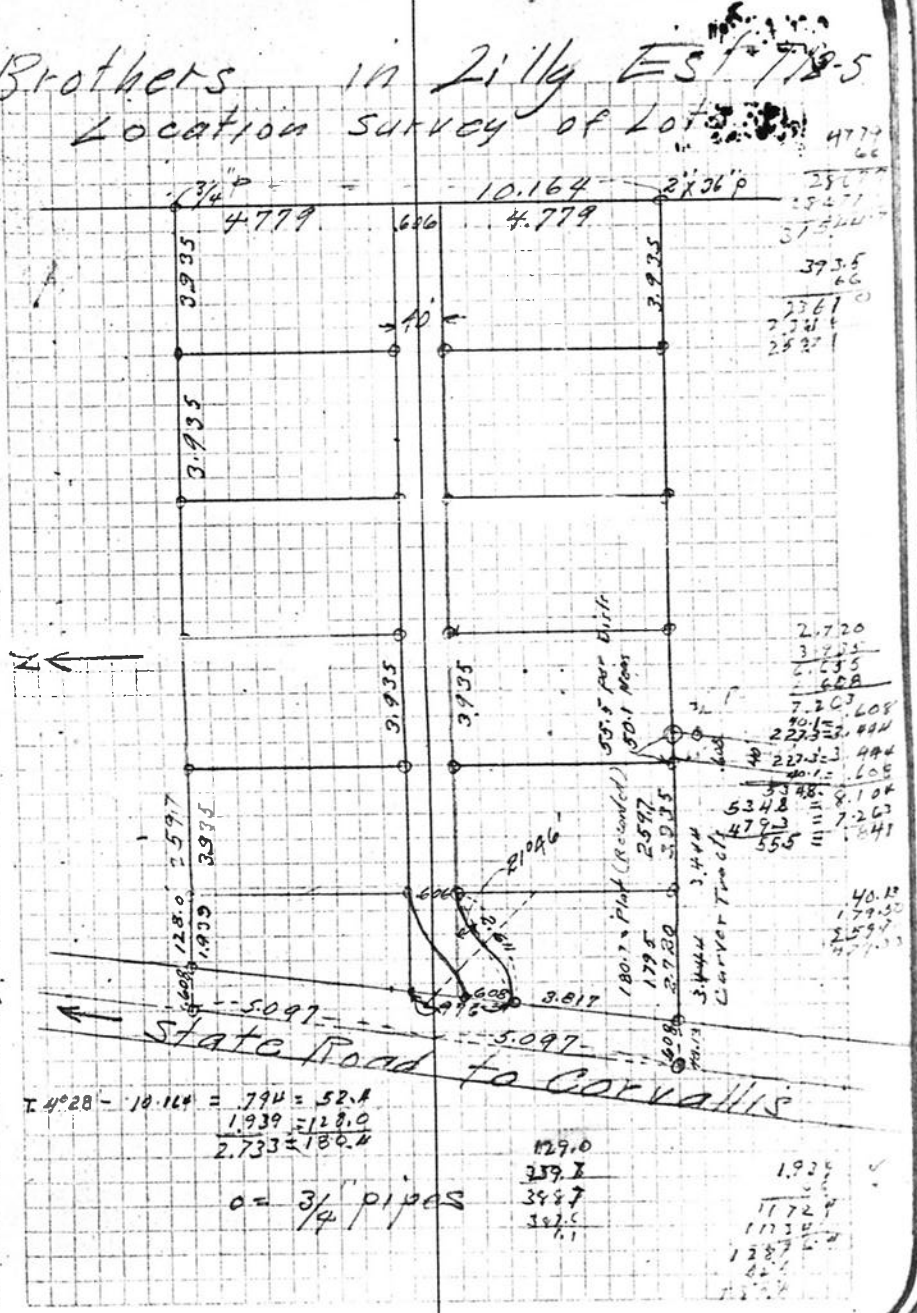
A Reversed curve was put in road at West end to make better approach for Mill Race Bridge.