C.S. # 768

CREES BLOCK

CORVALLIS, OREGON

Scale 1"= 40'

W.C. Galloway C.E.

July 8, 1921.

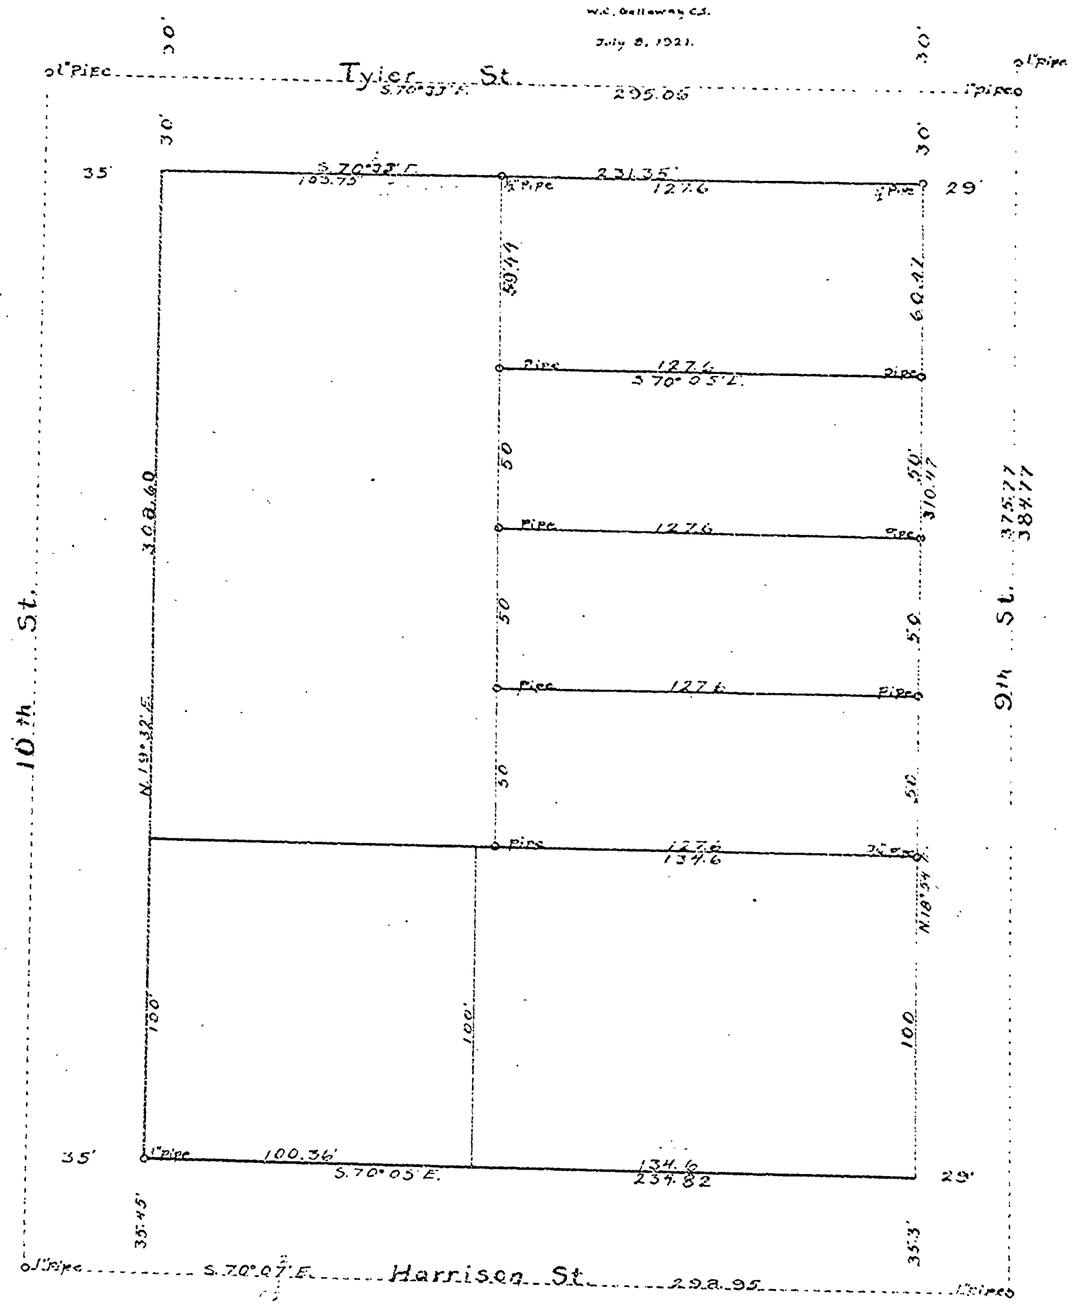

768

47

C.S. # 768

CREES BLOCK

CORVALLIS, OREGON

Scale 1"=40'

W.C. Galloway C.S.

July 8, 1921.

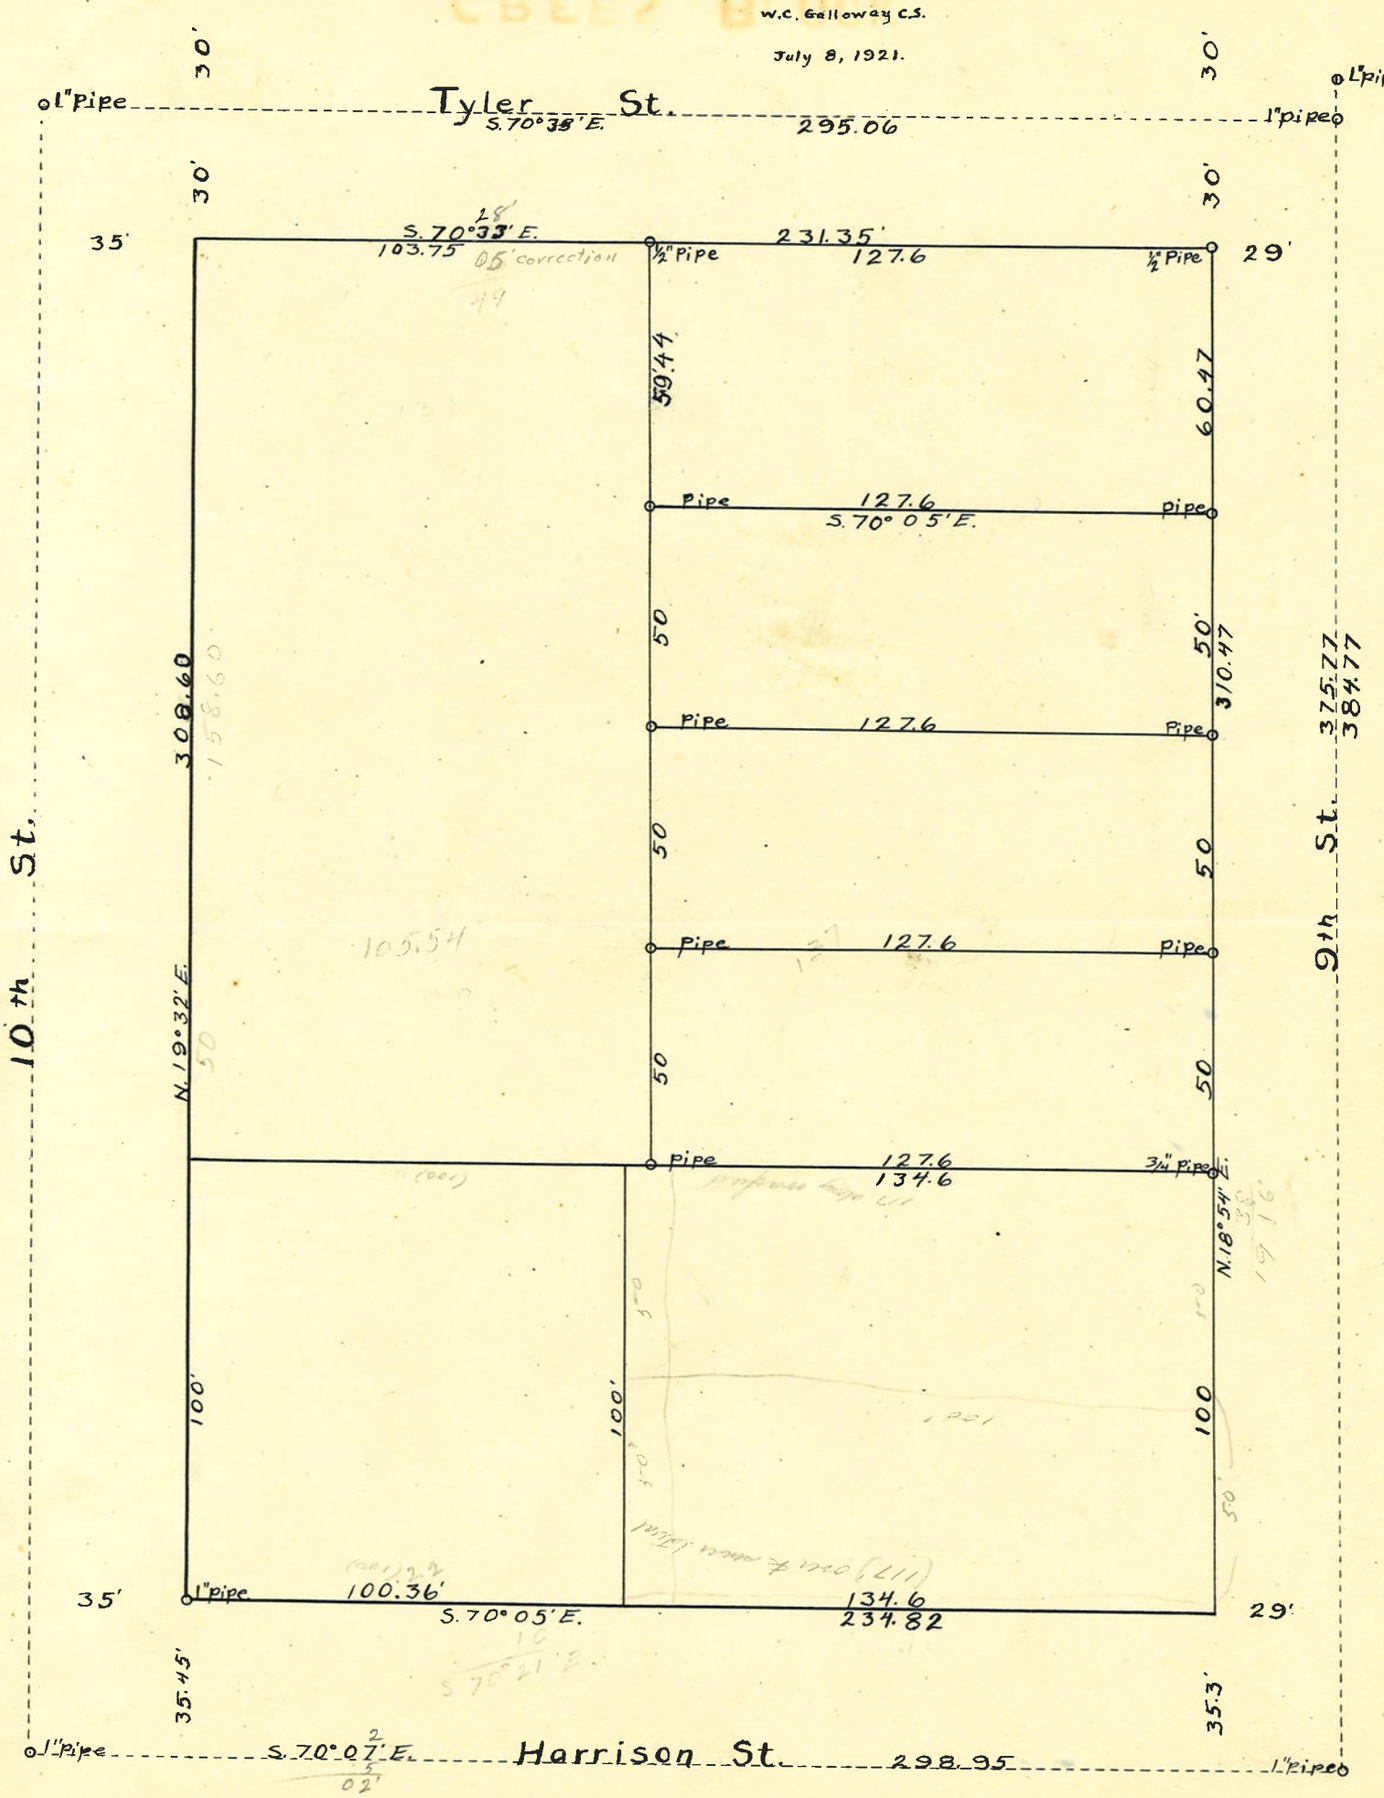

768

47

51 #768 FB#28.
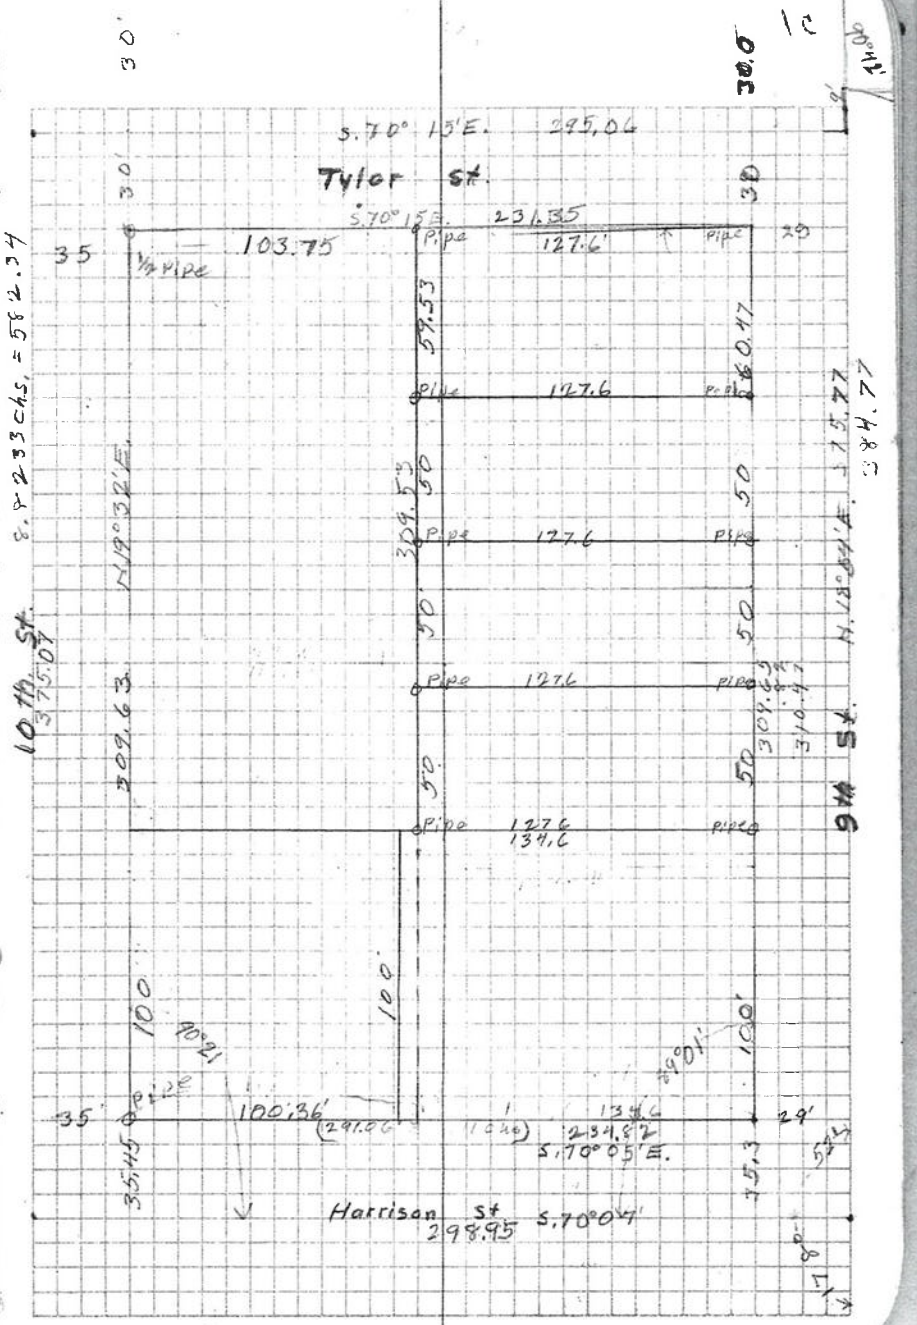
C.S. For S.N. Warfield
in Block between 9 & 10 Sts.
Harrison & Tylor Sts.
In William Dixon C.L.50
Sec. 35 T11S. R5YY