771

BLOCK 2

COUNTY ADDITION
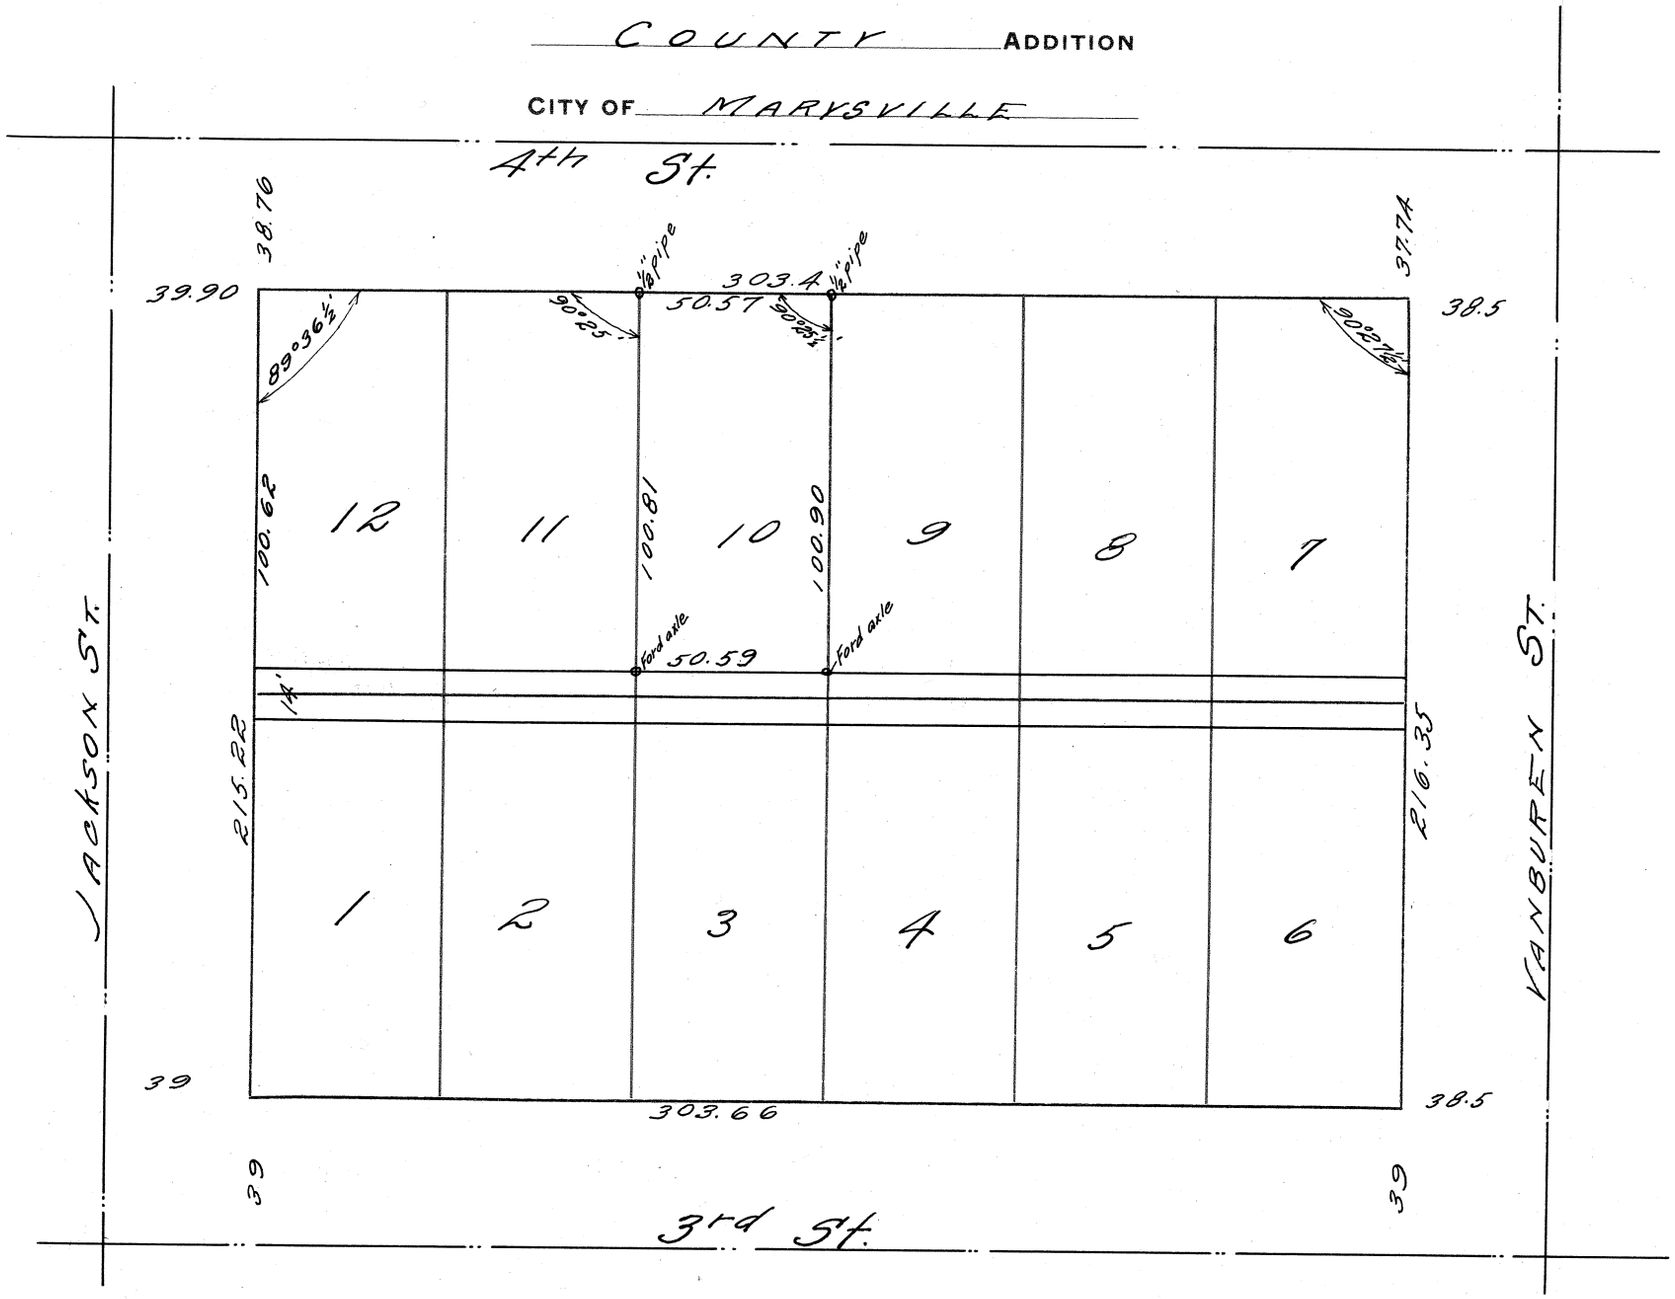
CITY OF MARYSVILLE