C.S. # 777

Hardcopy 14-5 #17

also see notes in file

F. B. 29-38

38 # 777

FB #29

C.S. 254 Con. T. 14-5
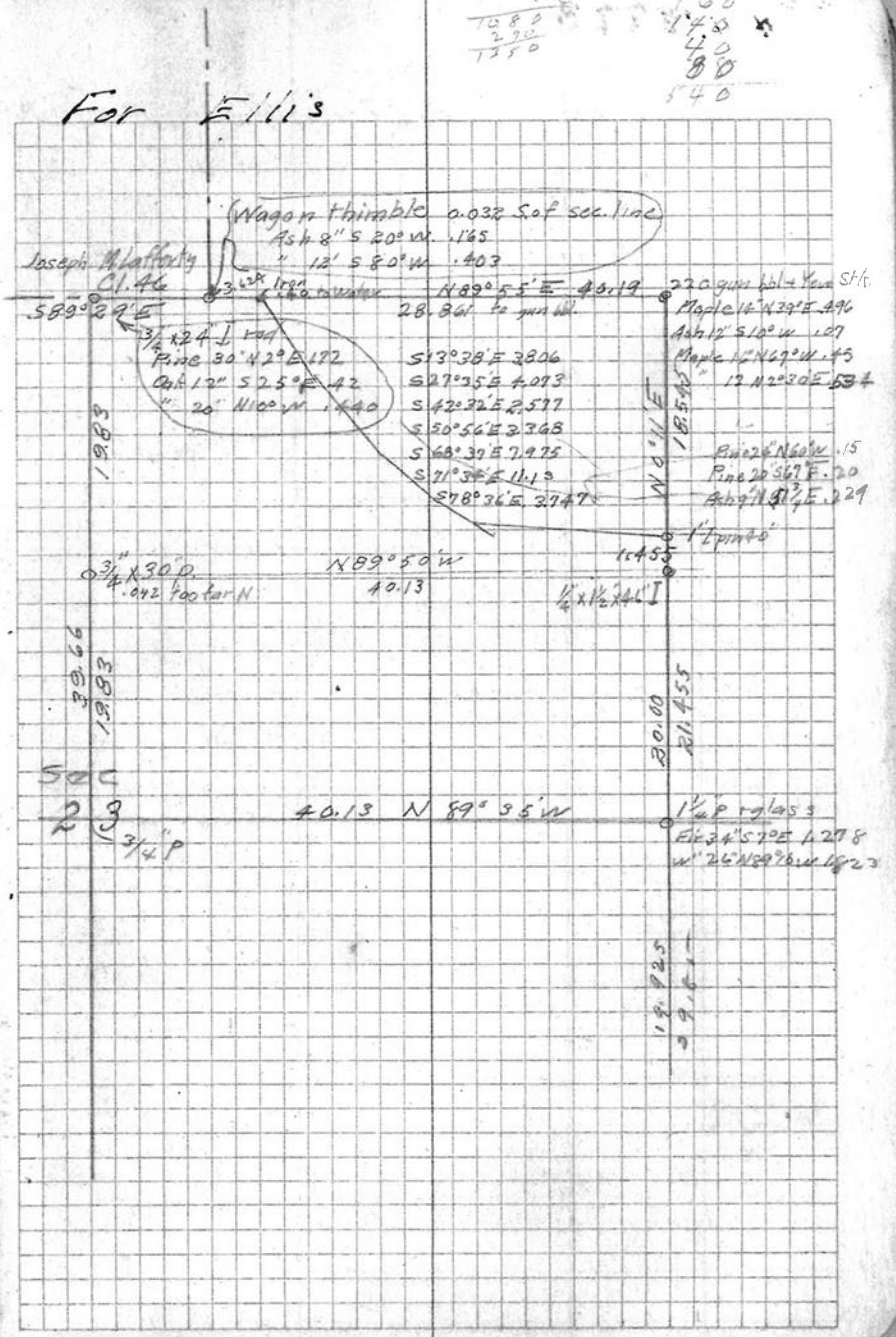
For Ellis