C.S. 778

BLOCK 4

N.B. & P. Avery's ADDITION

CITY OF Corvallis

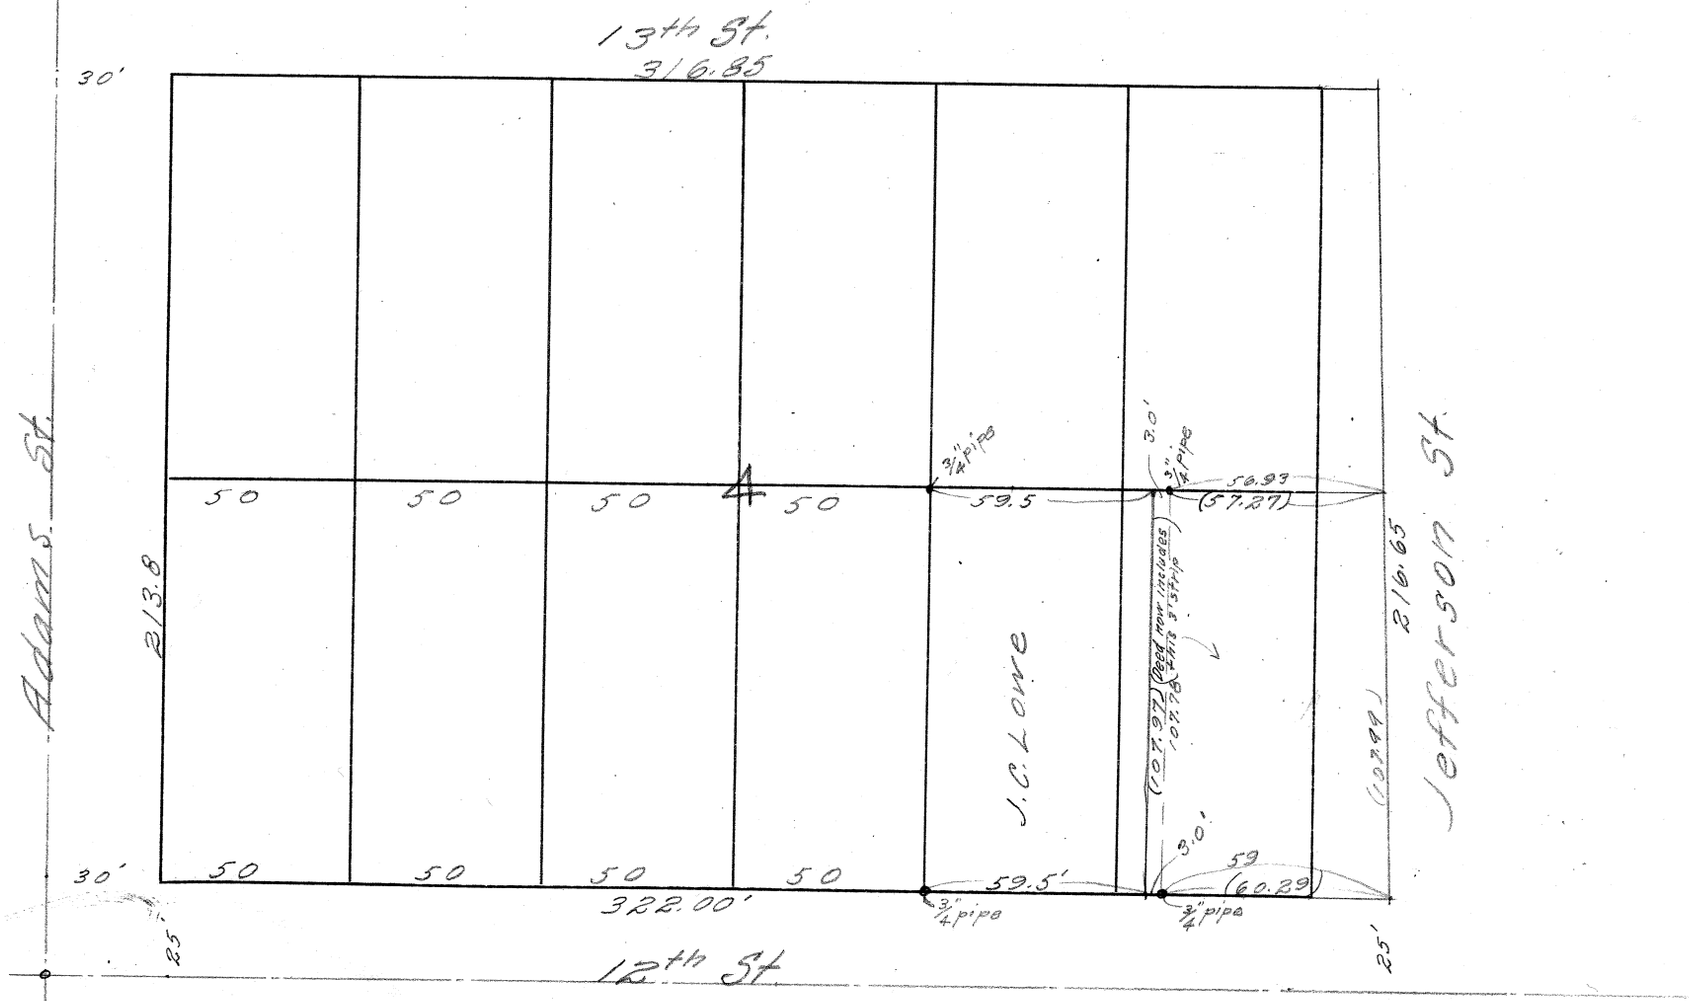

44