C.S. # 779

See notes in file

F.B. 29-41

41

#779

FB# 29

Block 10 North College Hill
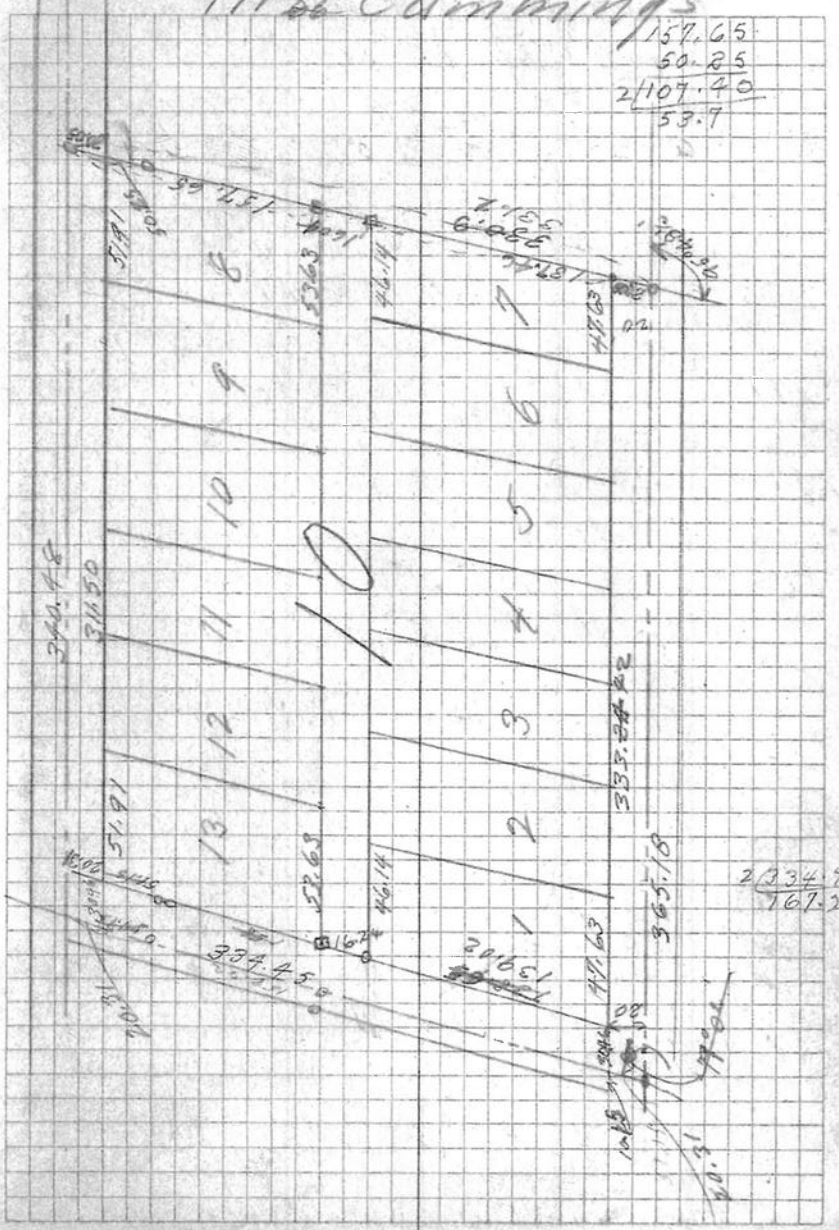
Mrs. Cummings