C.S. # 780

See notes in file

F.B. 29-42

AR FB #29

C.S. 274 con. #780

In Sec. 2 T11S R4W

Began at ~~pt~~ N.W. cor of stone + pipe

Rainwater el 39 Mag

A_0 011.2 380° SE

A_1 5.909 S0°10E

A_2 7.860 correct 0° 21' W

A_3 R.R. rail N.E

.277 West to el cor S.W. Stone+Pin

A_3 Set .92 W for el line ?

.150 W to old fnc line

A_3 81°58' R

A_4 22.296

9.38

A_5 ~~90°07'30"~~ to fnc fnc N-S.

13.253

B_3 .05 E of ℄ edge of house.

9.267 90°0' R

B_2

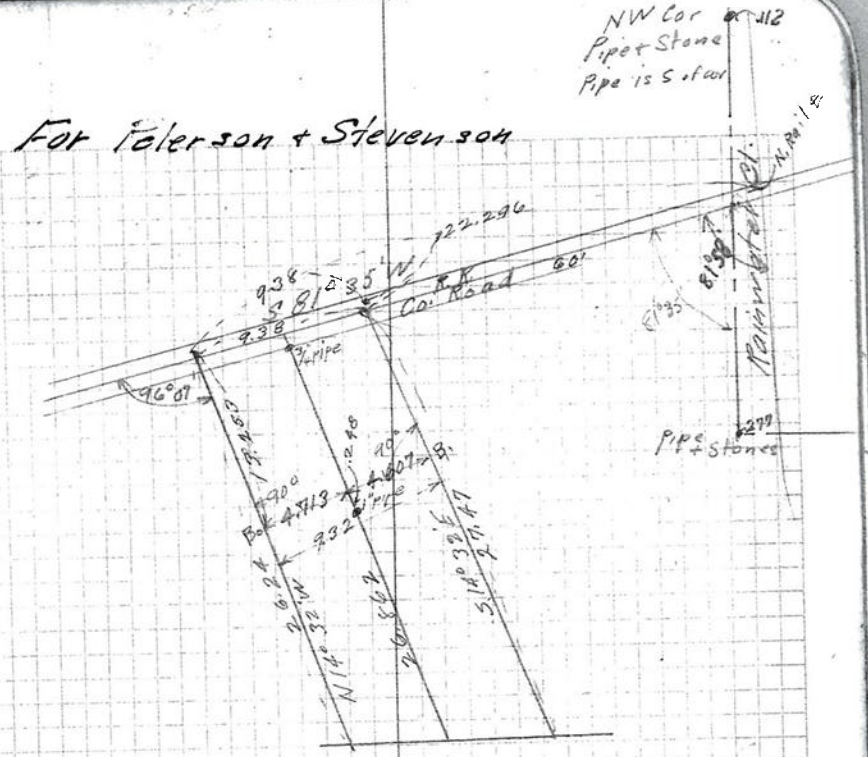

For division line

Set .053 E of ℄

.248 S of B to Pt