T.12 R.5 Sec 2

C.S. # 784 Survey Made by Hazeltine
Checked " Porter
Aug 1921

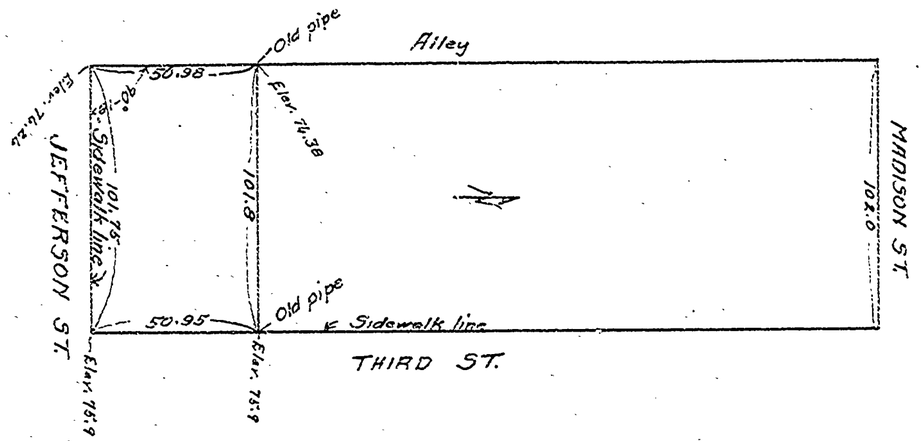

C.S. 784-A

BLOCK 16 ORIGINAL TOWN OF CORVALLIS

SCALE 1" = 50'

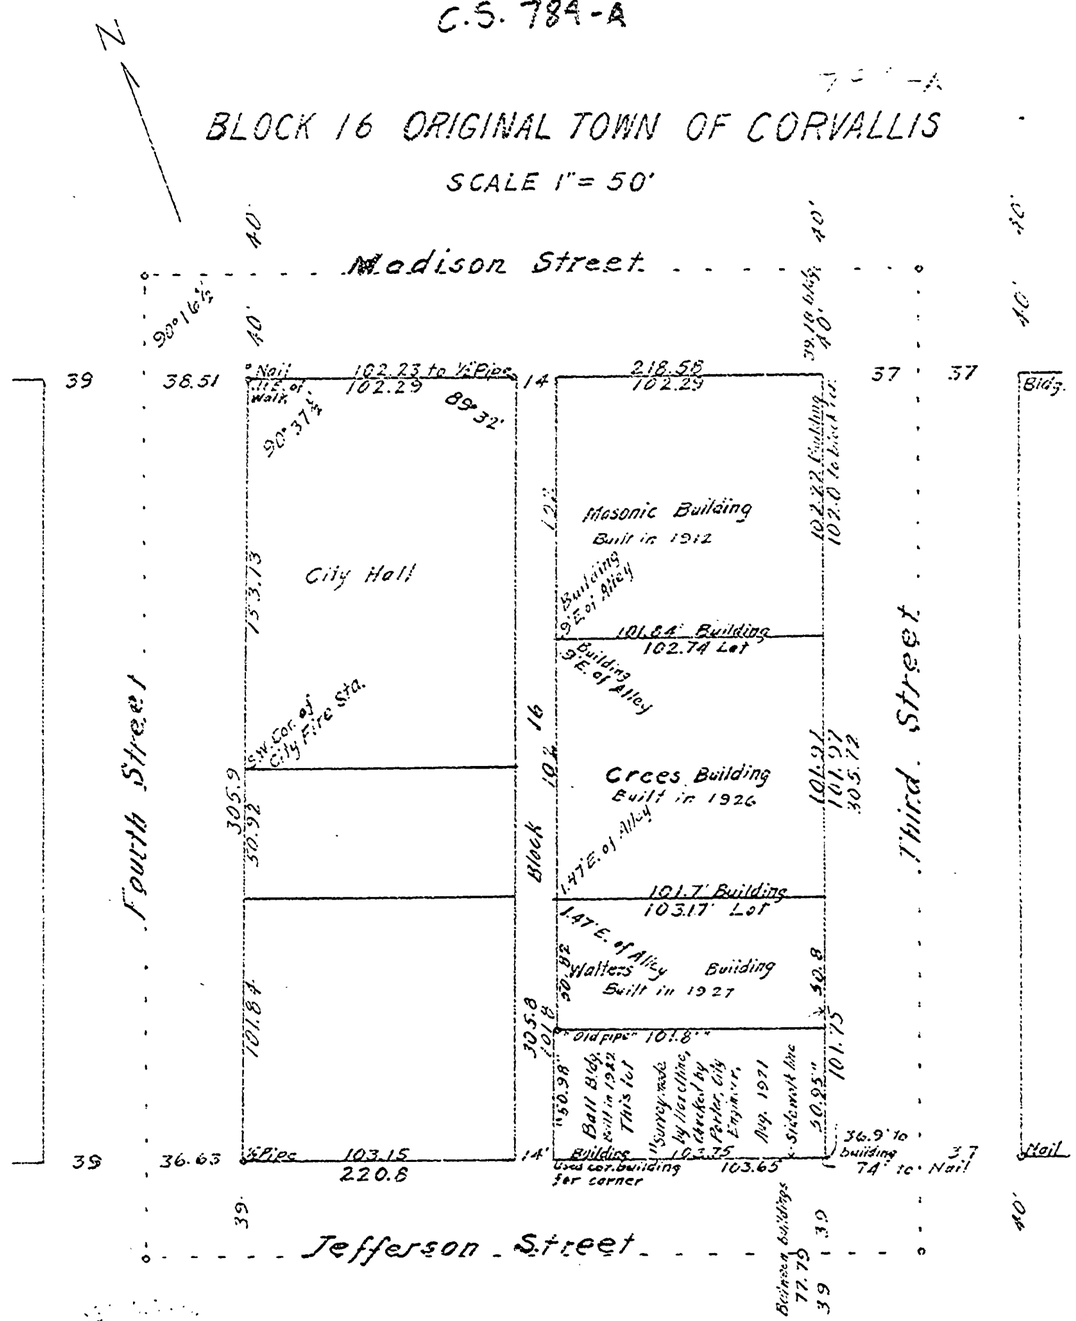

W. C. Galloway

I hereby certify that on June 8, 1944 I made a survey of Block 16, Marysville, Original Town of Corvallis, Benton County, Oregon. That the same is as shown on the plat hereon especially with regards to the Crees Building. That all buildings have been built more than 10 years and excepted as correct locations as far as I know.

W. C. Galloway Co. Surveyor.