#33

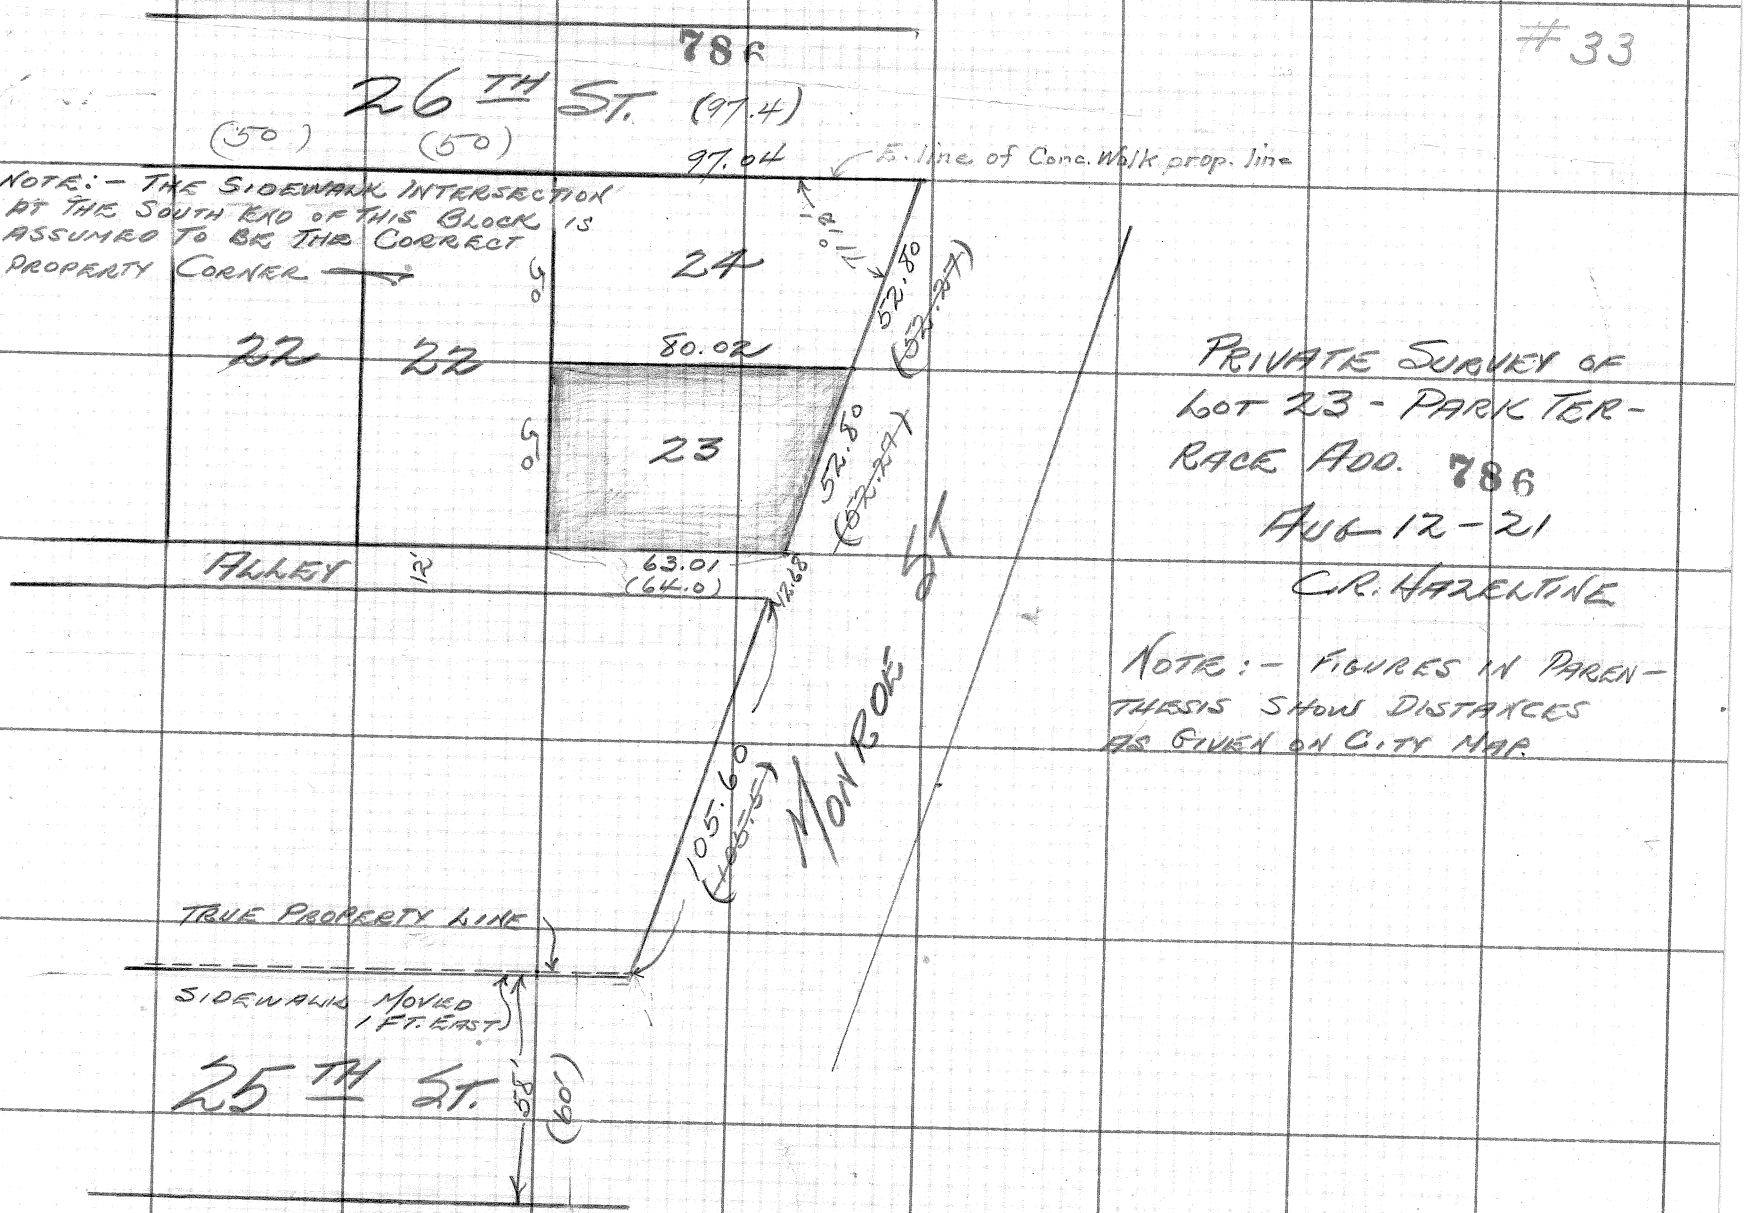

PRIVATE SURVEY OF LOT 23 - PARK TERRACE ADD. 786

AUG 12-21

C.R. HAZELTINE

NOTE:- FIGURES IN PARENTHESIS SHOW DISTANCES AS GIVEN ON CITY MAP.