787

BLOCK K

Averys ADDITION

CITY OF

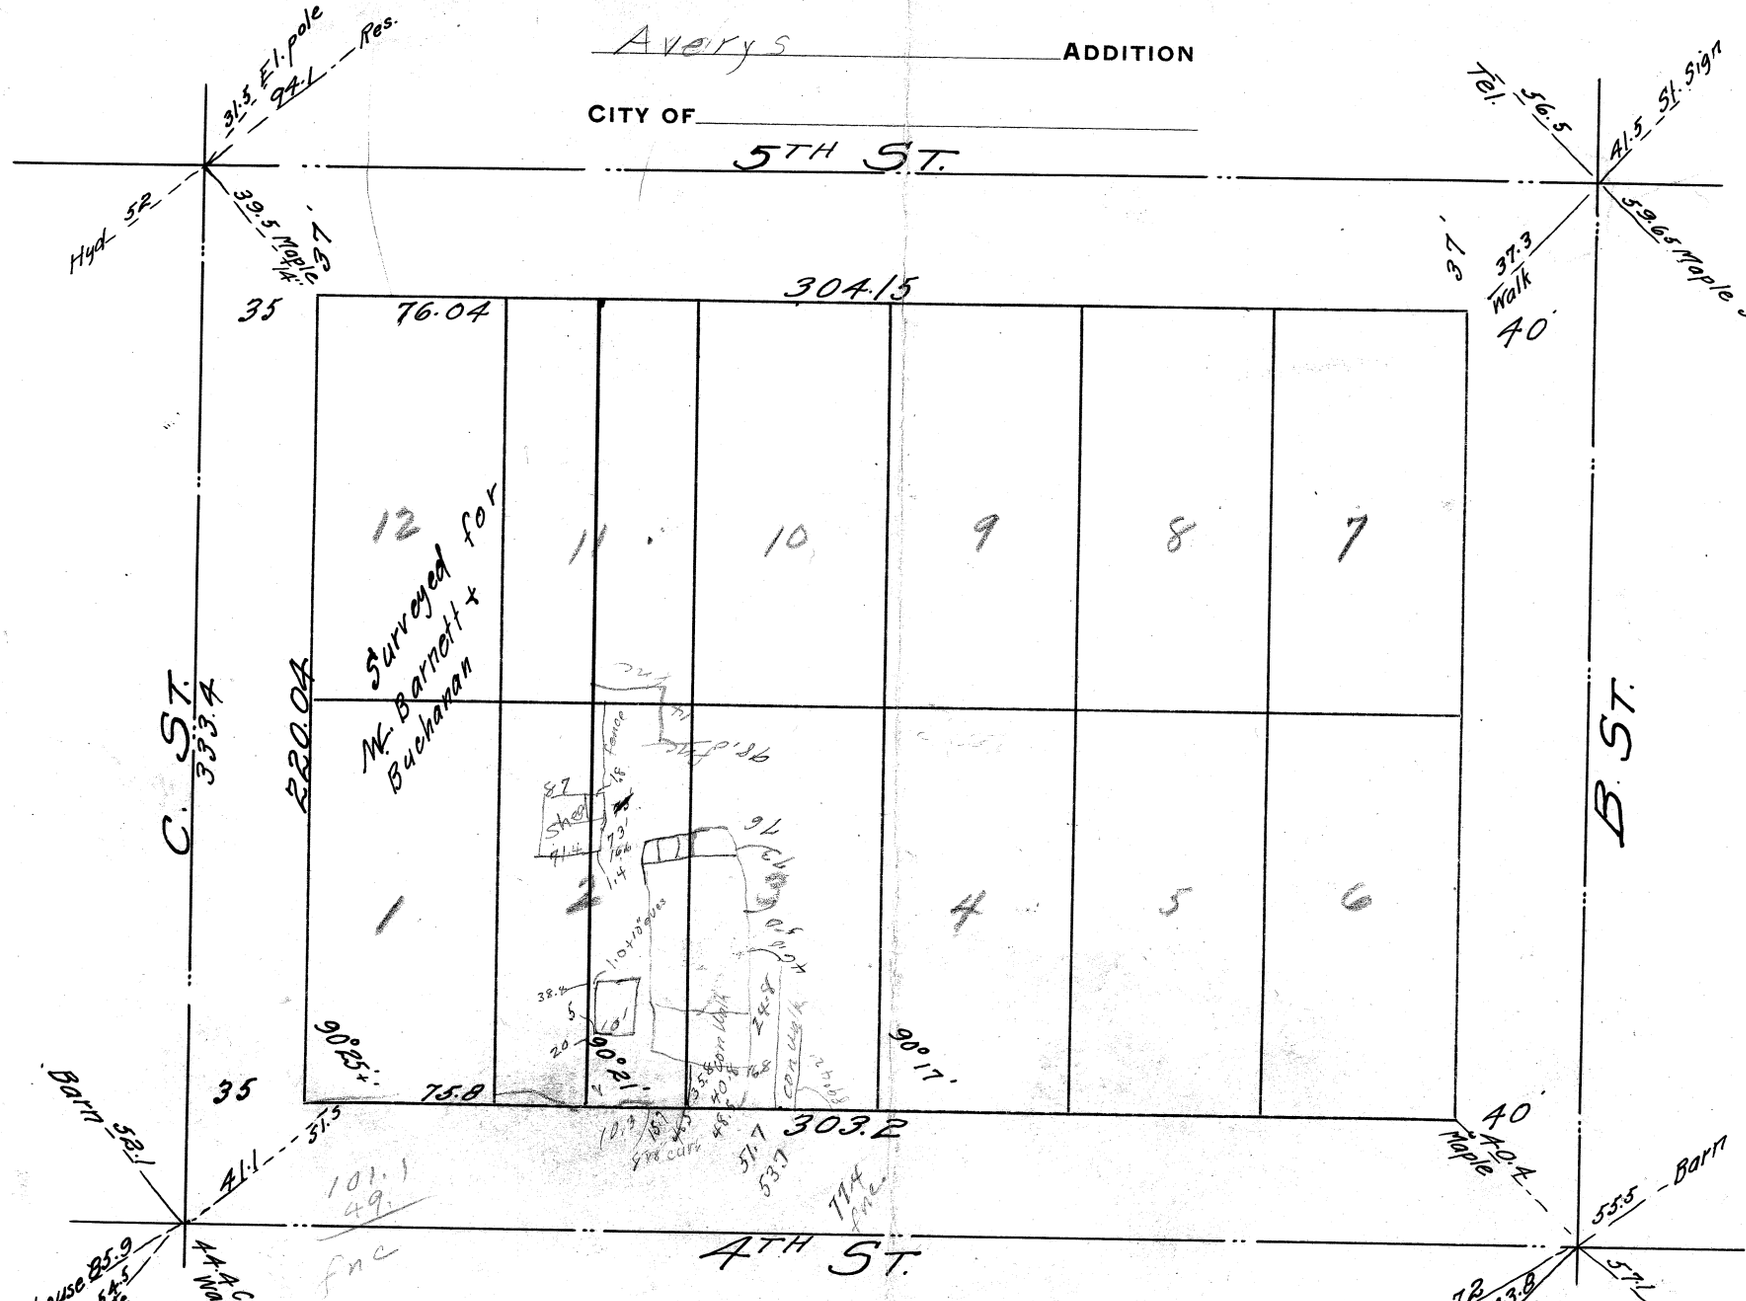

78