788

BLOCK 3

Chase's ADDITION

CITY OF Corvallis

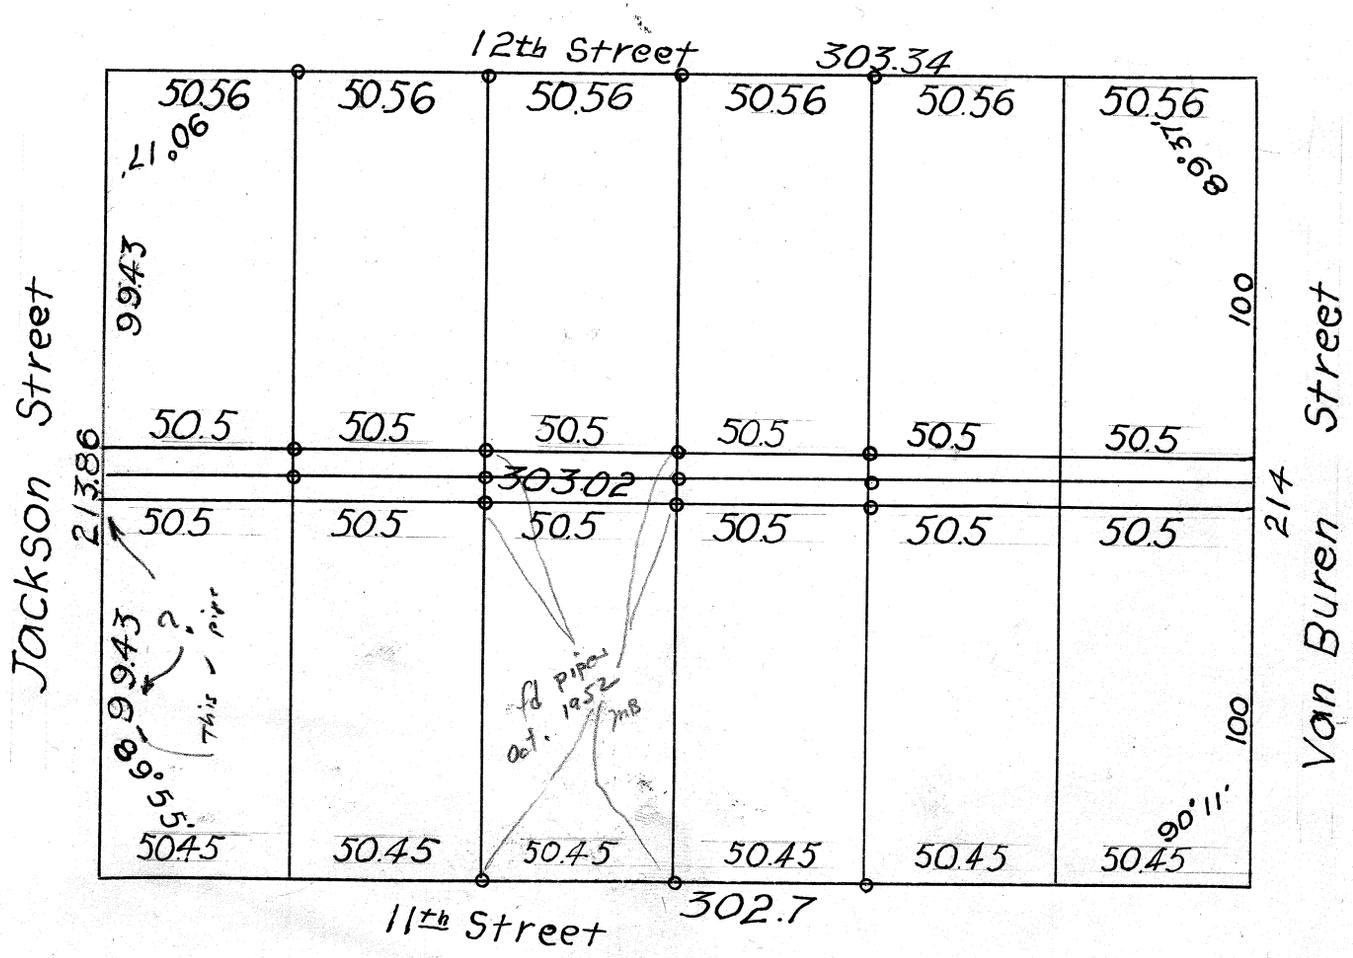

55