C.S. # 793

Hardcopy 14-5 # 3

also see notes in file

F. B. 28-54

54 #793 FIB # 28, PG 54-55

C.S. # 306 continued. For Ross Barclay

Beginning at △ 36 Book 25 Page 41

Said △ is 14.474 chs. W. from N.E. cor.

of James E. Barclay D.L.C. # 42

T. 14 S. R 5 W.

1	S. 89° 18' E. correction N. 17'	3.810	which ⊙ is 10.658 W. of N.E. cor. of C. 42.
		−.061	
		N. .096	which ⊙ is 10.65 K
	From △ 37		
2	S. 89° 18' E.	.880	
		E. 4.78	
		⊙ S. .155 of cor.	
3	South correction E. 6⅓'	2.670	W. .473
4		5.898	W. .462
5		4.170	W. .454
6		1.370	W. .451
7	∠ Left 22'	7.890	offset .050 E.
		−0.0	
		+ W. 4.87	
8		7.974	
9		6.511	
3 12 / 10 11	∠ Right 70° 47'	3.356	offset .454 W.
	To Oak Stake		

Oct. 14, 1921

S. 31° 55' E.

.01222
.155
2.670
5.898
4.170
1.370
7.890
22.153
7.974
6.511
3.325
39.963

.155
2.670
5.898
4.170 .850
1.370
7.890
22.153
7.974
6.511
3.325
39.963

88 48 / 40 2121 / 48 / .005 / 00240 / 149 / 51 / 004 / 155 / 00034896

.1222 / 48 / 00727 / 48 / 5816 / 29080

3.356 3.356
34531 97079
7.89 3356 30209
46 1006 3020
4737 167 23
315 13 3
05049 1 1
.4543 33250

.00185 = ⅛'

offsets 39.963 / .074000 / 39963 / 340370 / 319704 / 205660

.478 E.
.050 E.
.528 E.
.454 W.
.074 E.

55

Back to ⌂ 7

West .487

N. 23° 29' W. Pl. 2 3/5 ser W. 127 = 8-

correct 39' To make one line = 19.402

N. 25° 01' W. 8.169

N. 31° 58' W. 5.334

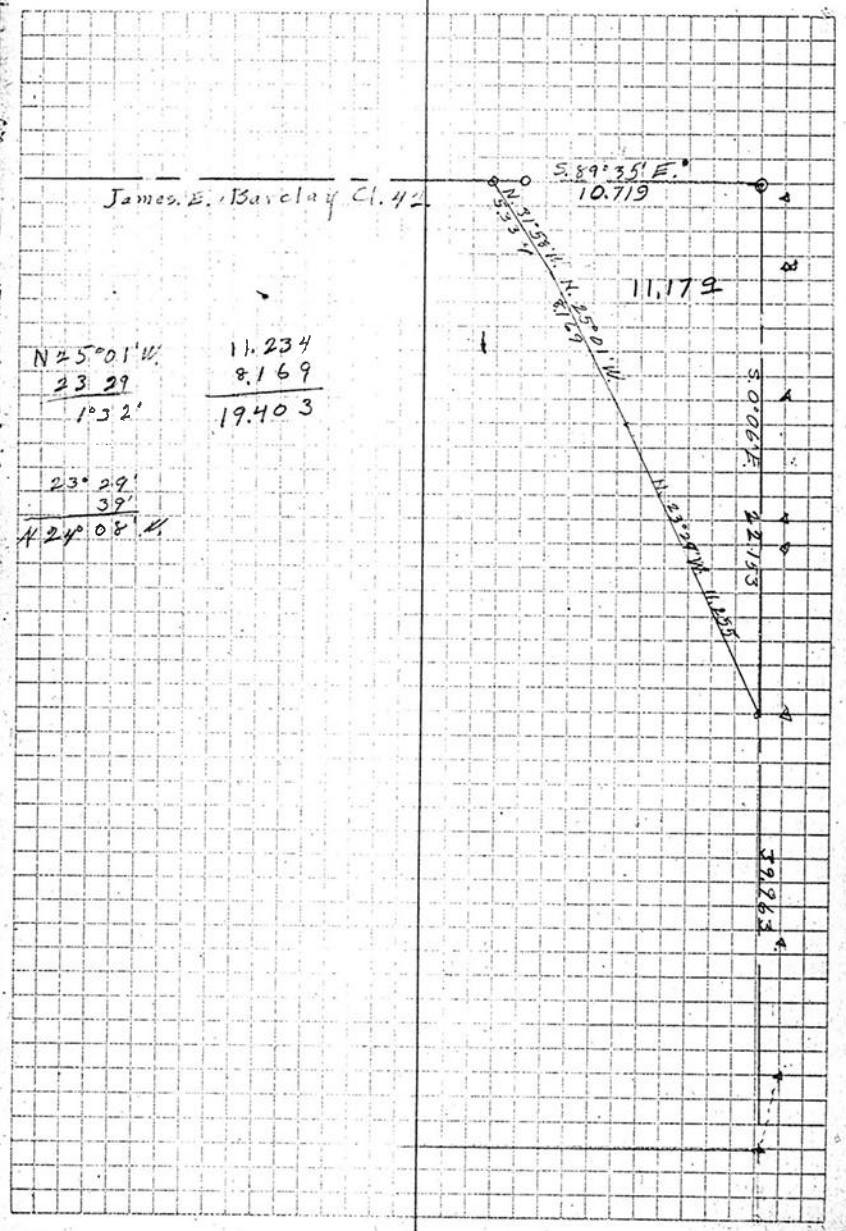

N 25° 01' W. 11.234

23 29 8.169

1° 32' 19.403

23° 29'

39'

N 24° 08' W.