C.S. # 795

Hardcopy 10-5 #5

also see notes in file

F. B. 28-58

F/B 28, PG. 58 C.S. 795

58

#795

C.S. 284 Continued

Beginning at Glenders' N.W. cor.

D.L.C.

T. 10 S. R5W.

| | | | | |
|---|---|---|---|---|
| | | | Backsighted S.38°40'W. | 4.983 |
| Thence | N. 40° 56' W. | | 11.330 | |
| 2 | S. 62° 47' W E. | | 8.540 | At .50 Set ½" g.p. |
| | Set ½" galv. pipe | | | |
| 3 | S. 35° 07' W. | | 10.10 | |
| | Set ½" galv. pipe | | | |
| 4 | N. 70° 23' W. | | 7.979 | |
| 5 | | + 1° 30' | 8.020 | |
| 6 | | + 4° | 7.577 | +.137 To Iron Pipe |
| | | | +.038 | |
| | Set ½" galv. pipe | | | |
| From | N. W. cor. of D.D. Davis C. | | Supposed | |
| To be ½" pipe | Back Sight on | | S. W. cor. of Hughes' | |
| as | N. 89° 56' W. | | 6.983 | |
| Set | N. 89° 51' W. | | .114 | offset |
| & | S. 0° 02' E. | + 1° 10' | 8.894 | We set a ½" g.p. S. .011 |
| 9 | Correction W. 6' | - 2° 20' | 3.666 | -.004 S. 70° 24' W. |
| 10 | | | 5.330 | +.033 S. E. 09 Set ½" g.p. |
| 11 | | - 2° | 7.698 | |
| 12 | | | 6.698 | |
| | | | +.012 | |
| | striking W. of cor. | | .060 | |

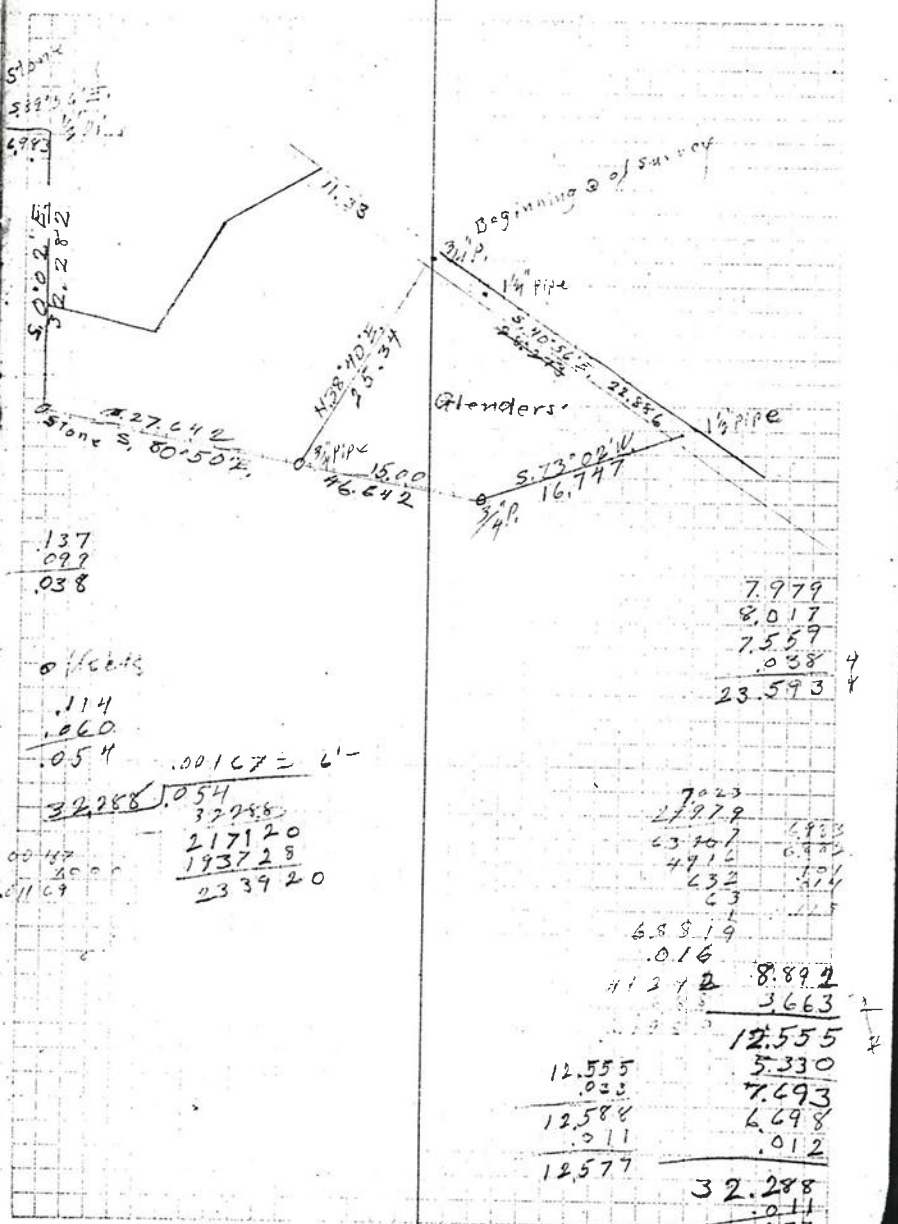


.137
.093
.038

.114
.060
.054

.001C7 = 6'-

32.288 .054
37.288
21.720
19.37.28
0.33920

7.979
8.017
7.559
.038
23.593

7°23
27978
63401
49116
6332
63
1

6.8 8.19
.016
8.892
3663
12.555
5330
7.693
6.698
.012
32.288
.011
32.277
32.371
19.700

12.555
.023
12.584
.011
12.577