797

BLOCK 20

Town of Marysville ADDITION

CITY OF Corvallis

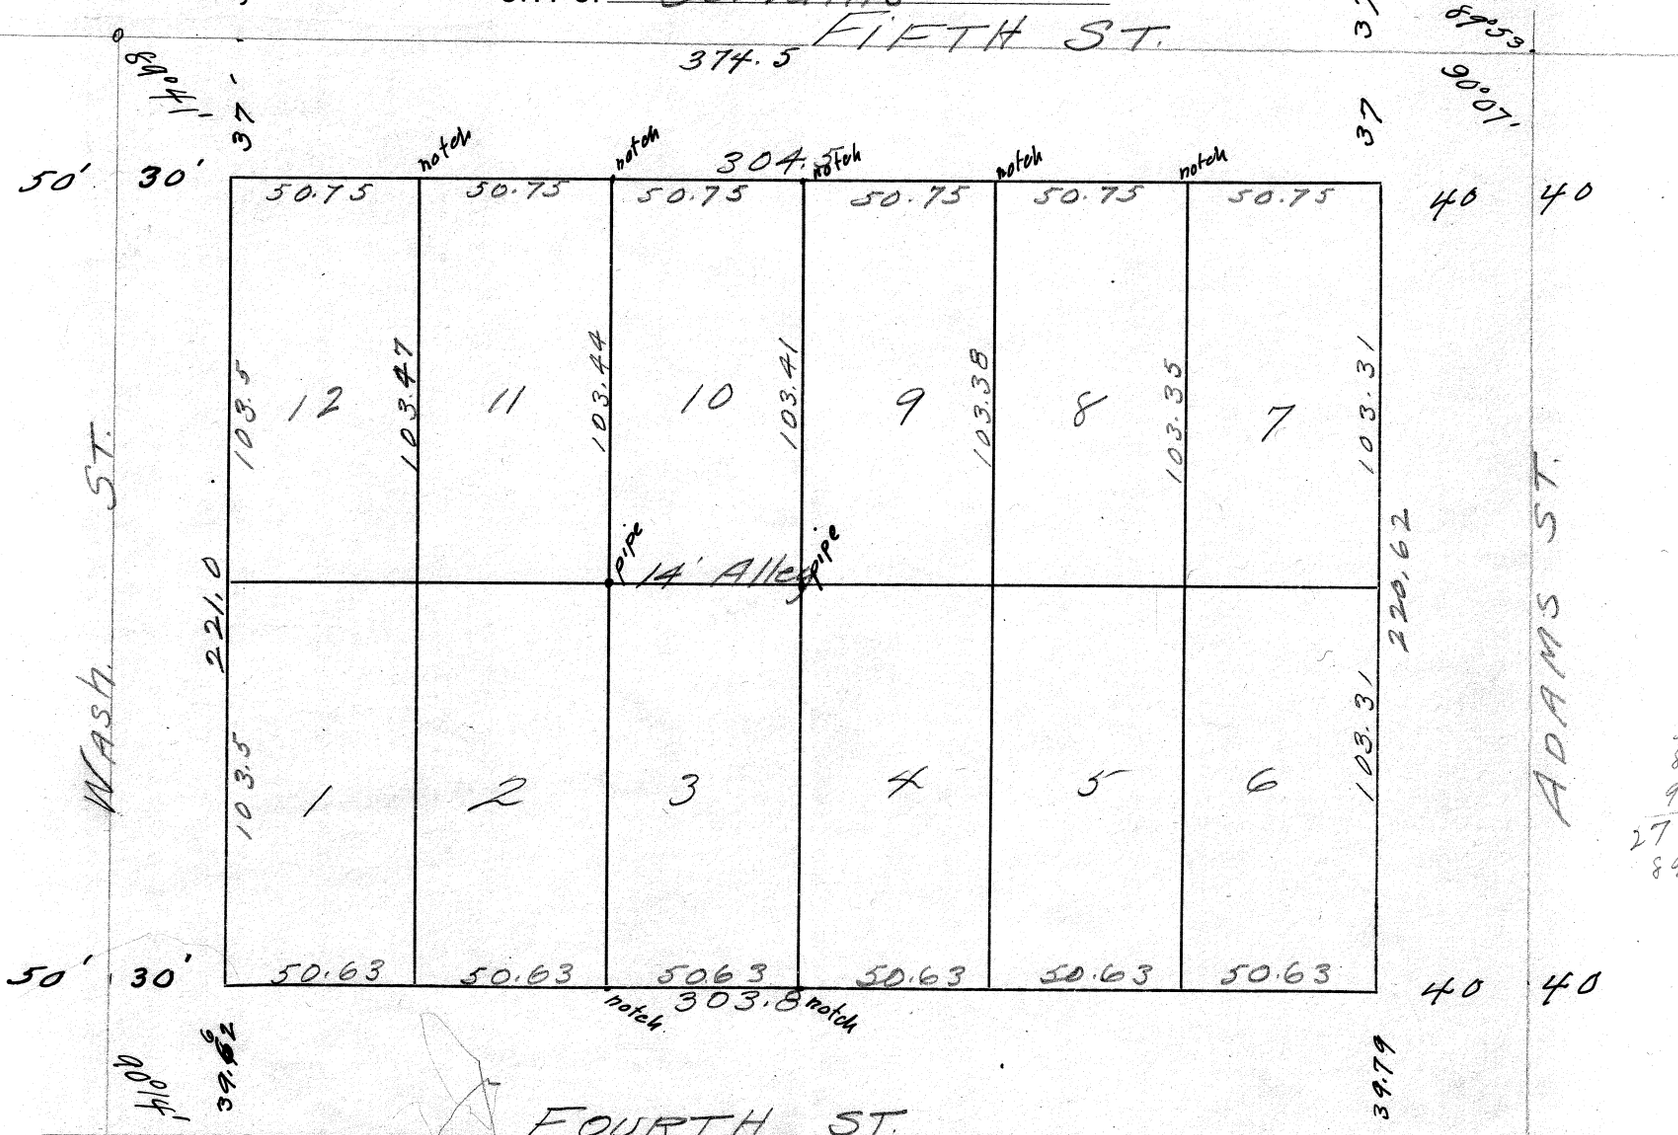

90-07
89 41
90 14
270 02
89°58'