BLOCK No. 5

College Hill Addition to Corvallis

798

Note:- Pipes marked thus 3/4" set by F. Marion Wilkes and shown in supplemental plat.

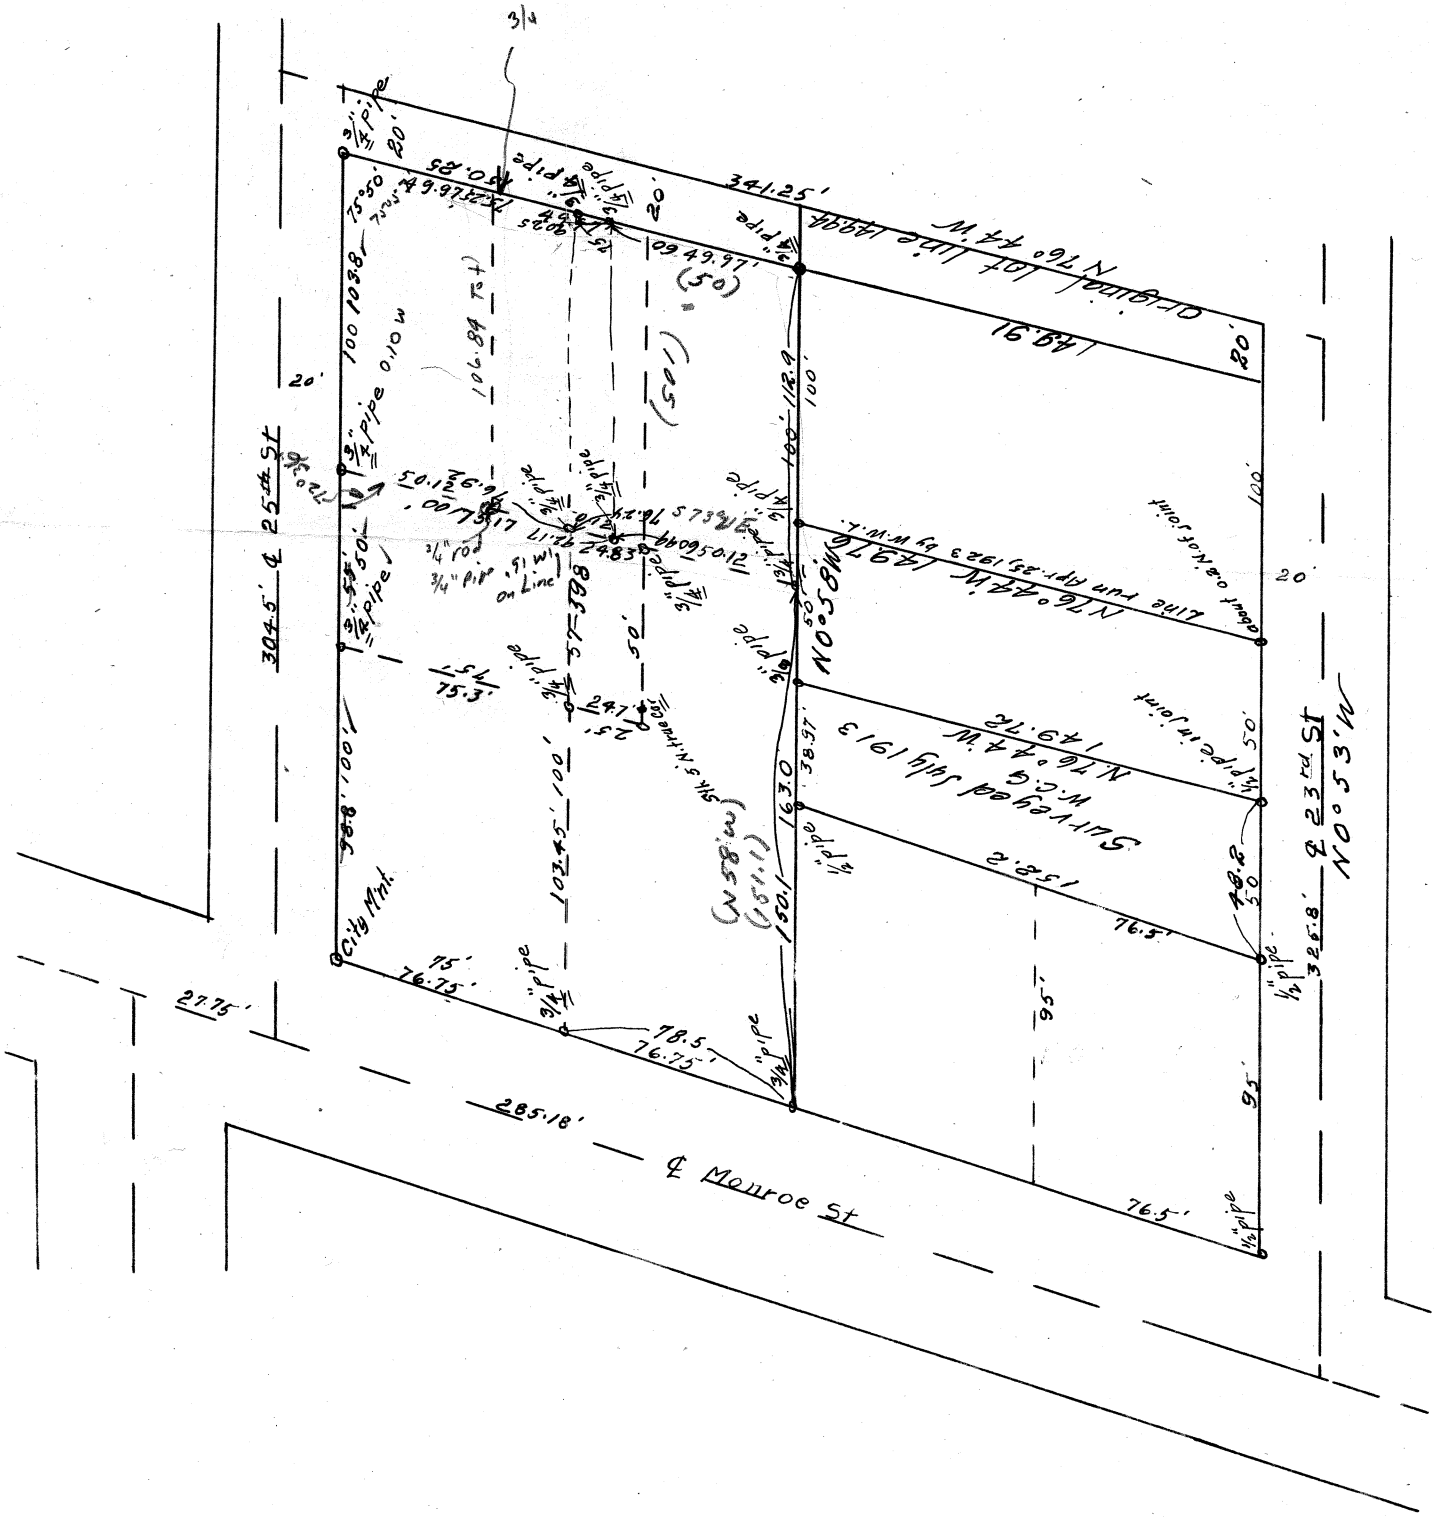

124 3/4
75.80
179.53

49