C.S. # 802

Hardcopy 13-4 # 2

also see notes in file

F. B. 29-57

57 FB#29 C.S.218 cont T13R5W

#802

Hulbart Cl. 1st sec Seth Hulbart.

Begin at NW. Cor. Cl. 60

Set brick N. 85° E 2.64 (W 1.29 N. 0.80)
Ore "E" S 85° E 2.64
"N" S 74° .5' E 2.47
Sun Obs S 80° 22' E 3.38 to Reef
Found a rock bat for cor of sec
S 50° 1' E.
By Sun (S 50° 20' E)

8° 55' R

S. 8° 41' W

180°

98° 37' from pt N.

N 89° 56' E

0° 18' R

S. 89° 46' E

123° 06' to hub on form

N 32° 52' W

1921

Sun Obs

Time Non 7 - 10-18 A.M.
H 26° 42'
V 25° 07'
10-21
A: 26° 03'
25° 20'
H 26° 13'
V 22° 23'

90°00 Rod from Cl. to Reef
-2.285 pf East of N¼ cor
= 50.838 Cl. to to ¼ cor

Reef Sin 8° 55' = .15500 ÷ 1.148
Cos 8° 55' = .98791 × 2.407 = 2.317

52.623
Az 31 7
59.940 7.635 + .080 = 60.655

1.148
.475
.673

S¼ cor pt. set Stone
23.903
17.522
41.425
- .580
40.845
.349
40.296

Pt. on Cl. N 30° W 13.95
Pt. on Cl. N 53° E 2.00
Found 2 iron Mkd
Found C 89° 25' 84'
to Stone
-1.484
.635

As formerly set
Cl. cor is .0045 and .560 W
Cl. cor is N. 3.261 & 3.484 of hub on former transit line

58

33°08 R to transit line
119°03 L to Lwan which is claim cor.
S 28° 05' W.

560
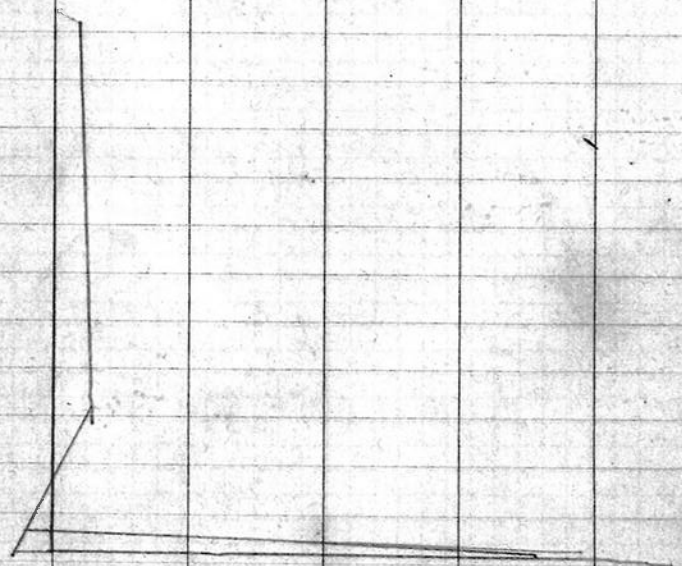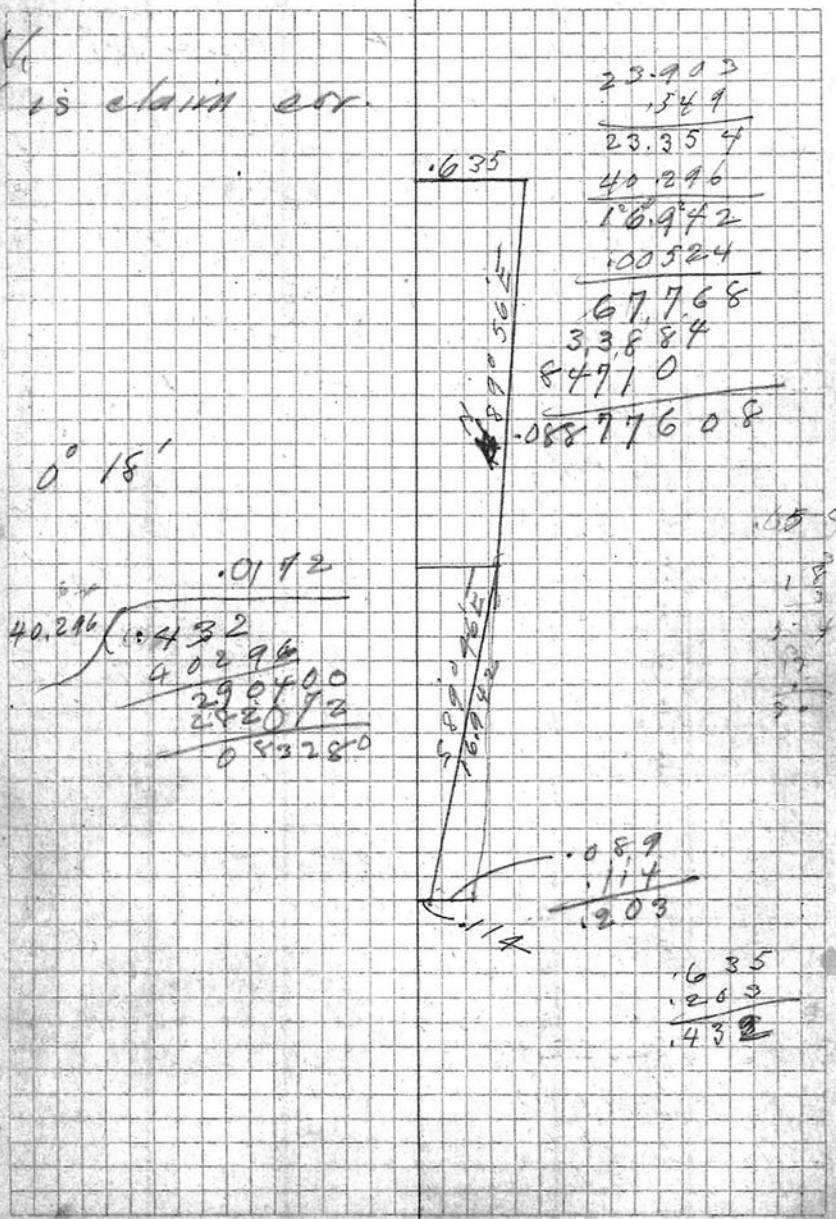
Set cor. 11 South
to make proportional
measure for Claim
come out right.