C.S. #805

F.B. 29-65

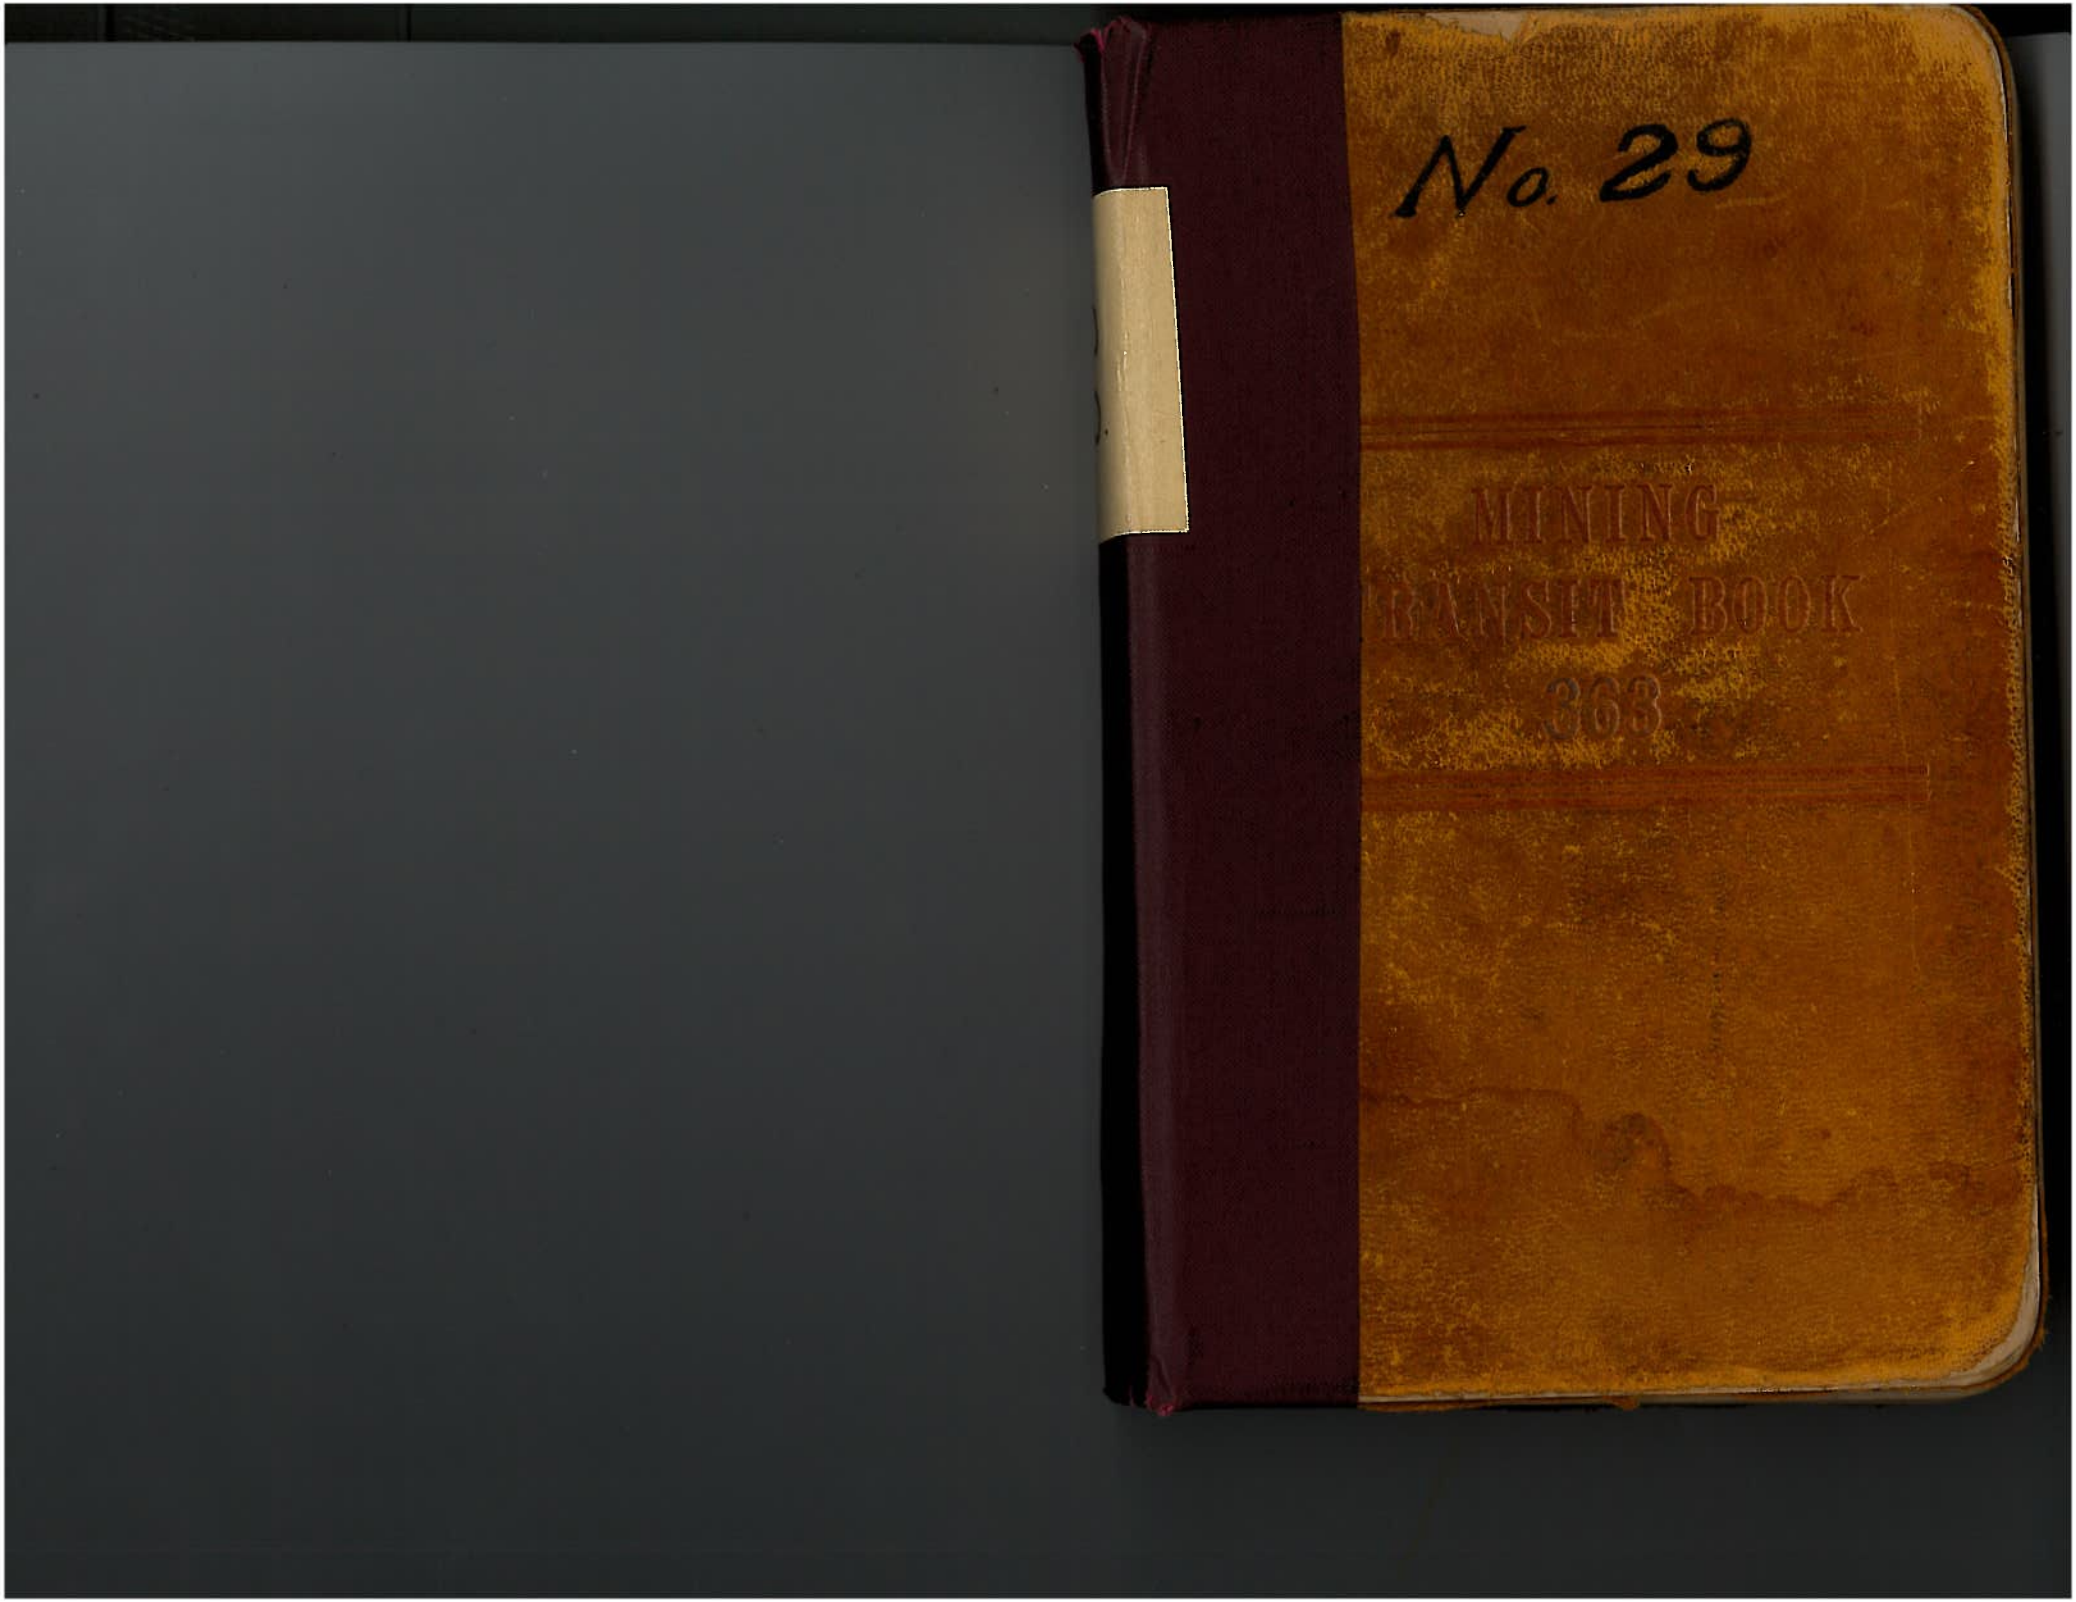
No. 29
MINING
TRANSIT BOOK
363

65

Survey for Plowed Area of field for Curtiss in Sec. 19 T11S R4W

#805

Sta	Dist	Az.
△3+75	~~300~~	From cor. near shed
	380	10°45'
	73	69°40'
	255	94°13'
	410	115°05'
	530	131°0'
8+75		
	370	95°36'
	414	136°10'
	425	152°40'
18+75		
	IR Sh. 677	16°52'
	387	24°35'
	370	45°50'
	341	54°26'
	410	96°26'
	700	142°32'
	460	180°
23°30'L 500' △	Az = 157°30'	
	89'	255°38'
	125	209°24'
	177	173°2'
	190'	121°60'
	205'	135°26'

66

37°08'22" = 1438'
+28 A = 42°52'
△

128	14 55'
324	176 50
372	200 12
470	207 47'
510	215 52'
555	221 21'
360	274°30
168	271° 14'
153	285°

From SW cor
E 31A5
△

64'	270°
208'	211°40'
305'	191°05'

180° = N
5+50△ 230 207
246 36' 22
500'
△

336	301°41'

202°37
500
△

125	184

179°50'
5000
B

94'	231°30'

67

166°0'
5005

160'	180°
265	164°43'
730	160°
420	166°
620'	142°25'
505'	118°0'
630	54°42'
720	56°21'

12.93
5.53
7.20

693
3
2079