C.S. # 808

See notes in file

F.B. 29-70

70 F/B 29, Pg. 70 C.S. 808

#808

C.S. 22 cont. for Christy and Morgan

T 10 S R 4 W
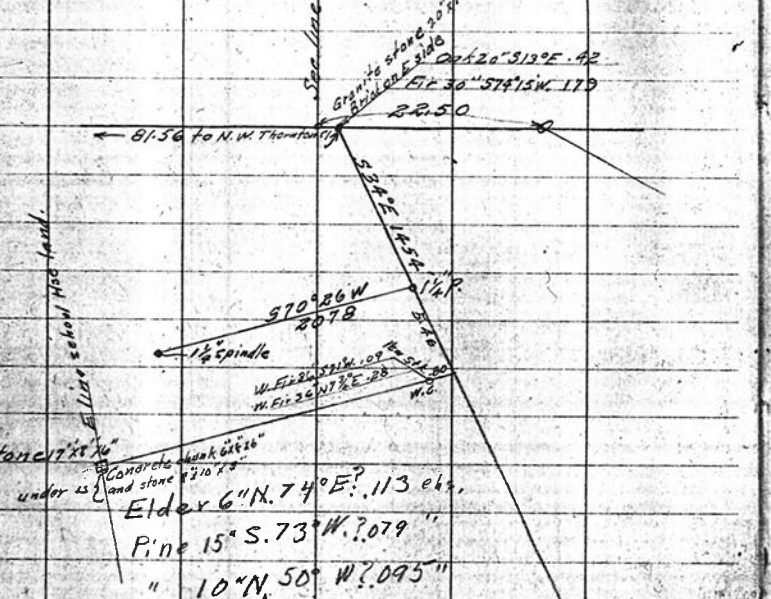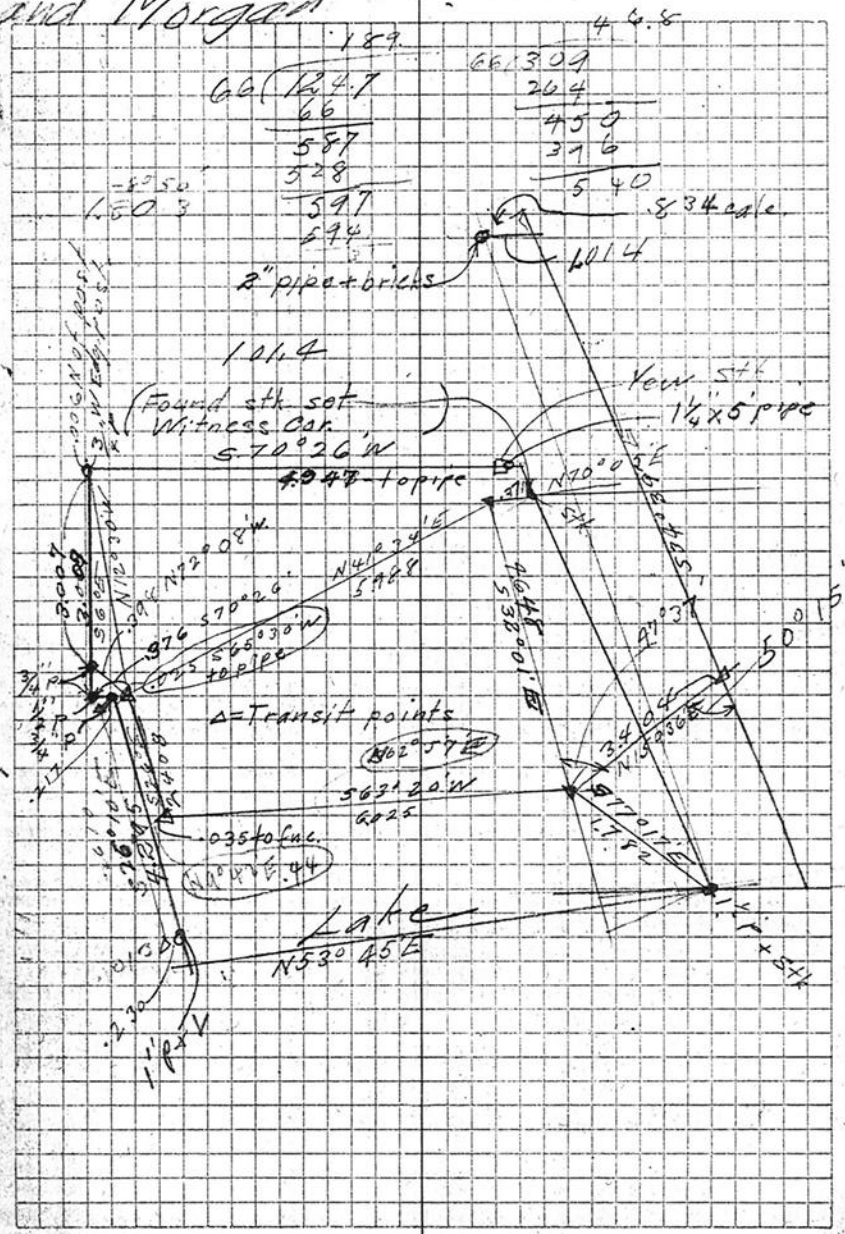
Plat of survey and corners as set by commissioners in suit of Worrell vs. Cooper + Worrell vs Perfect