C.S. # 811

See notes in file

F.B. 28-67

67

#811.

29'
39
.09320

FB#28.

66.67
66.67
133.37

3037
.2032
6074
9111
.09.71184

20240
133.37
69.03
66.67
135.73

Block 2 in Wilkins Add.
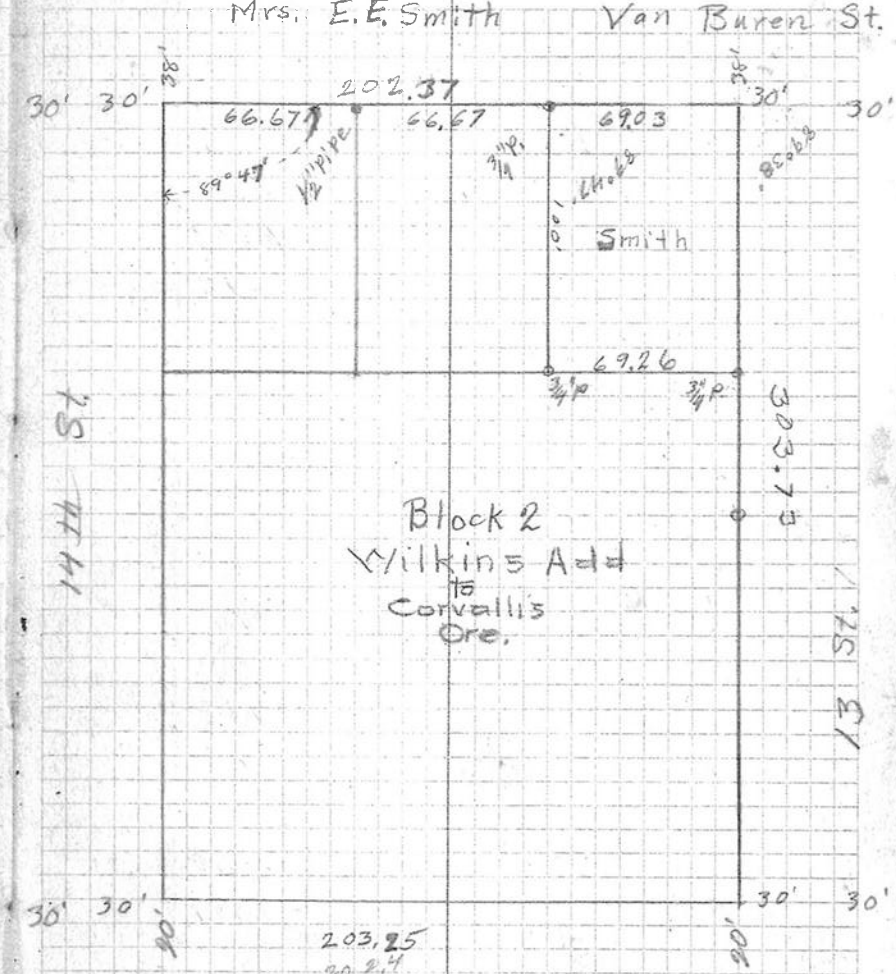
Mrs. E.E. Smith Van Buren St.