C.S. # 814

Hardcopy 14-6 #7

also see notes in file

F. B. 28-70

70 #14 FB#28

C.S. #118 Continued

From S.W. Corner of T.P.

Adams Co.

1	West		17.920	
2			7.773	
3			6.934	5.90 Cent. Muddy
			+.873	= .50 ℄ Muddy
	Set 1½ Pipe			
4			3.822	1.00 S. to ℄
			+4.00	to ℄
5	North		3.114	
6			7.194	
7			1.750	
			+.494	
8	West		4.168	N.491 +3.100
			+2.879	Brk. +.45 ℄
			4 N. 489	
	Back to △ 7			
9	East		18.624	
10			11.362	Set ¾" Pipe N.505 +E.3
11			6.432	
			-.065	= .5 CN.
	Set 1" Pipe		N.516	

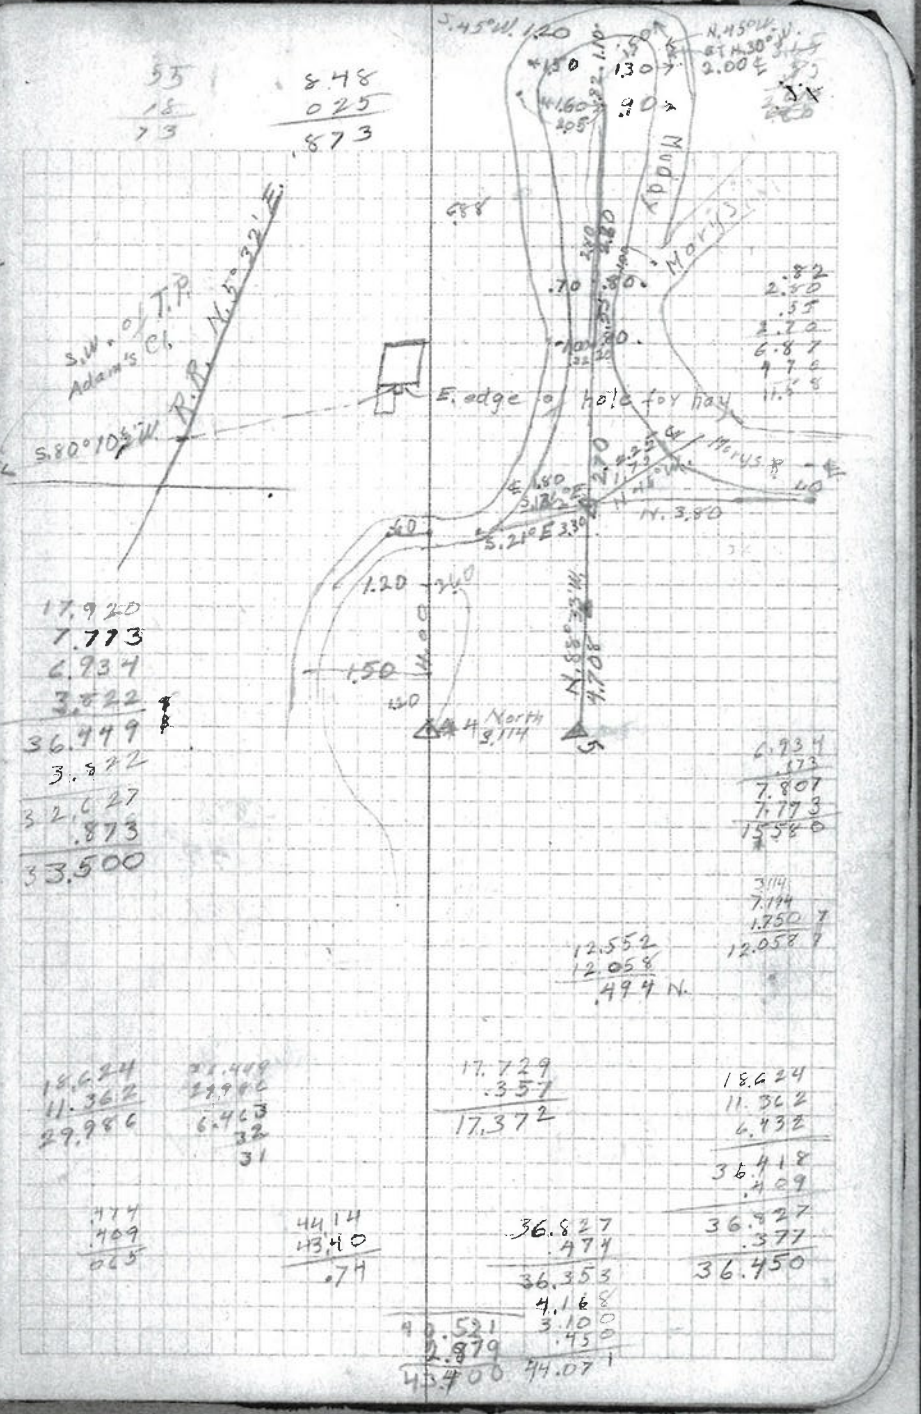

71

12				.409	
13	South			12.036	
	Striking E. of cor.			.377	S.W. of TP. 2 brs. S.E.
14				14.400	
To S.E. of Hiram Allen's	S. 58° 20' W.			14.357	
13 back to △ 12					
15	North			14.865	opposite 42.40 ft about 6ft W. of ℄ R. S.W.
	correction W. 27'			-.045	
				∴ W. .585	
	Set 1¼" x 30" pipe				
	Set ¾" pipe	West		3.00	
16				3.542	
17				9.401	
18				.132	W. 68C
19	West			7.884	
20				5.015	
	Striking N. of Pipe			.057	

12.058
12.036 .0060 = 2'
.022000
21870
12000

36.45

409
31
.377

12.552
12.036
.516

26.90
26.56
.045

12.036
14.865
26.901
3.542
9.401
.132
39.976
05

line seems to be S. 0° 02½' W.
Line S. 89° 57' W.

.00772 = 27'-
40) .309
280
290
280
100

14.529
.129
14.400

Corner post - 7.90 to bank which is about ¼ of R. N.
△ 15 is 3.60 E. of ℄ River. .564 W. to Post

F. E. line of Hiram Allen Cl.
going N. 0° 02' E. (correction W. 1')

offsets	
12.220 E.	7.537
7.584 W	14.400
4.336 E.	12.036
5.015 W	14.865
.679 W	3.542
.657 E.	9.401
.022 W.	.132
	61.913
	.057
	61.856
	14.693
	80.549

.0036 El
.022 0000
18 45 55
557 320

7.537
14.400
21.937

12.220
.377
11.843
.006
11.837

7.884
5.015
12.899
.657
12.242
11.556
.686
.377
.309

.057
.024
.081

T. 125
No find
16 | 15
Oak 30" N. 22° E. 27
Fir 14" N. 63½° W. 154

	From △7				
21	North			6.260	
22				6.366	
23	N. 8° 03' E.			1.961	N. 8° E.
					S. 1/2° E.
					S. 8°30' W. to
24	N. 77° 26' W.			5.671	N. Lvts.
					-1.15 N.
2				6.780	+.45 cen.
	Back to △ 23				
	S. 77° 26' E.			2.50	N. of

6.260
6.366
12.626

3.35℄ of stream on West 1.25 N. to cen. + .55 ℄ N.
S. to ∠ in R
7.45 ℄ of UP Stream 1.50 to ∠ in R.
2.40 bnk. +.30 cen.
Lvts 2.90 cen. -.30 bnk. at ∠ ℄ S. 3.00 bnk. +.40 ℄
N. 2.25 ℄.

Lvts. 3.07+.45 cen. + E. 1.50 1/2 cen.
R. swings S. .30 or .40 thon on straight E.