C.S. # 817

Hardcopy 12-5 # 37

also see notes in file

F. B. 29-72

72 C.S. No. ~~314~~ 303 for Hulburt

#817 Jan 31, 1922

FB #29 P.I. on Highway at Sta. 742+48.2
3" N. of 1st expansion joint N. of
N. side Rowlands Road
½" Pipe is .330 S of R.P.P.I.
and .561 SW of P.I.

Hiram Allen 55
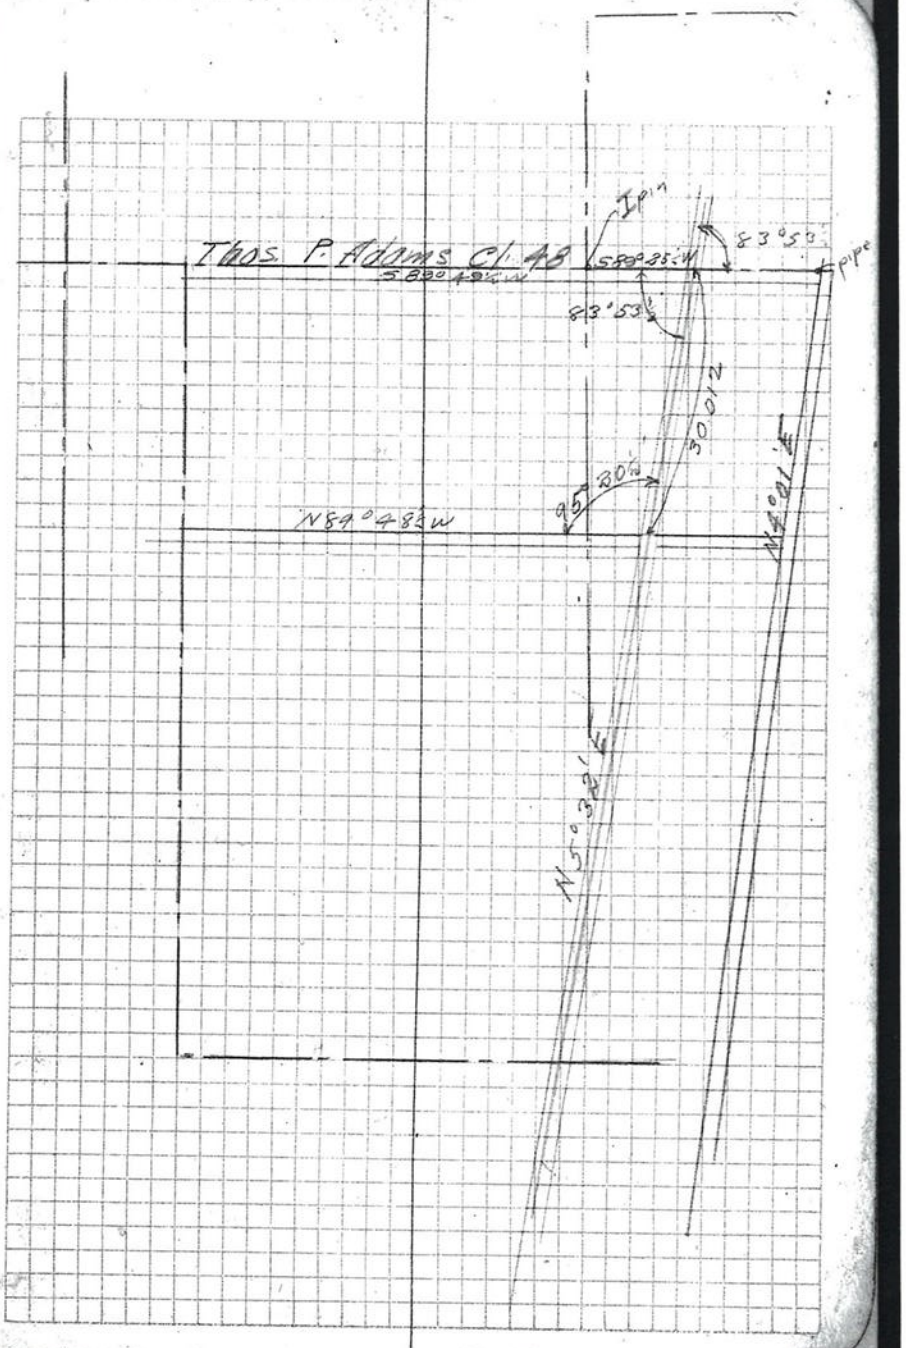
P.I. 15.692 to expansion joint in
line with fnc. on N. side of
Hulburt Lane
from Exp. joint in pav't to
pipe 82°45' R from line S. 5.36
Run from pipe W 19.645
E rail to I pin 15.071
Wiggled in betw pipe & pin
on RR w 83° 53½' / from S
Measure up RR 30.012
Lat angle from car by Rollids
to RR N = 95° 20½'
on E RW of RR set ¾" pin
Sign post N 87° W, 11.0
round Oak post N 2° E .065