114.6
113.6
228.2

832

Nicholas's 1st Addition to Corvallis Benton County Oregon.

Pg. 112
Vol 1
Towns

Plan & Survey

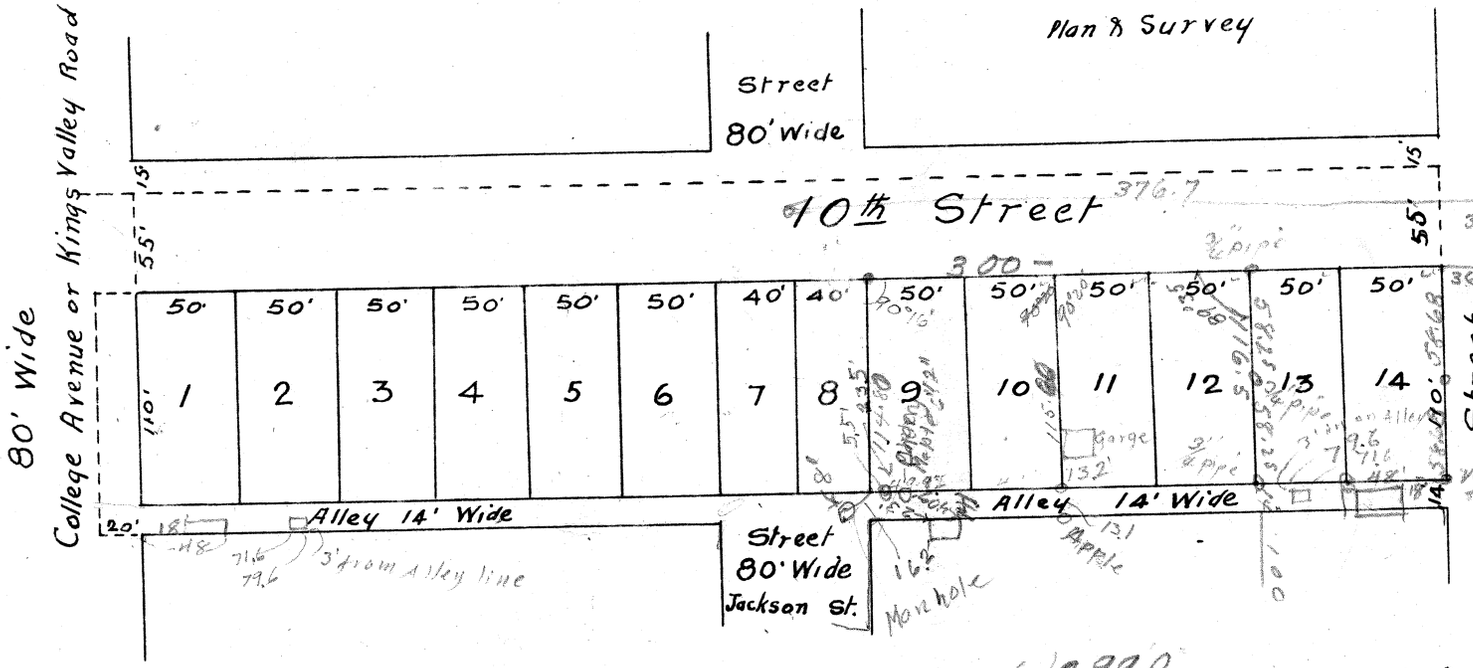

2/117.35
58.68

376.7

2/299.0
49.83 Recorded Dec. 4 1889

37.05
39.
76.05

Mockmore, Adriana M.M.
W½ of lots 13 & 14

36.0