833

BLOCK 11

MARYSVILLE ADDITION

CITY OF CORVALLIS

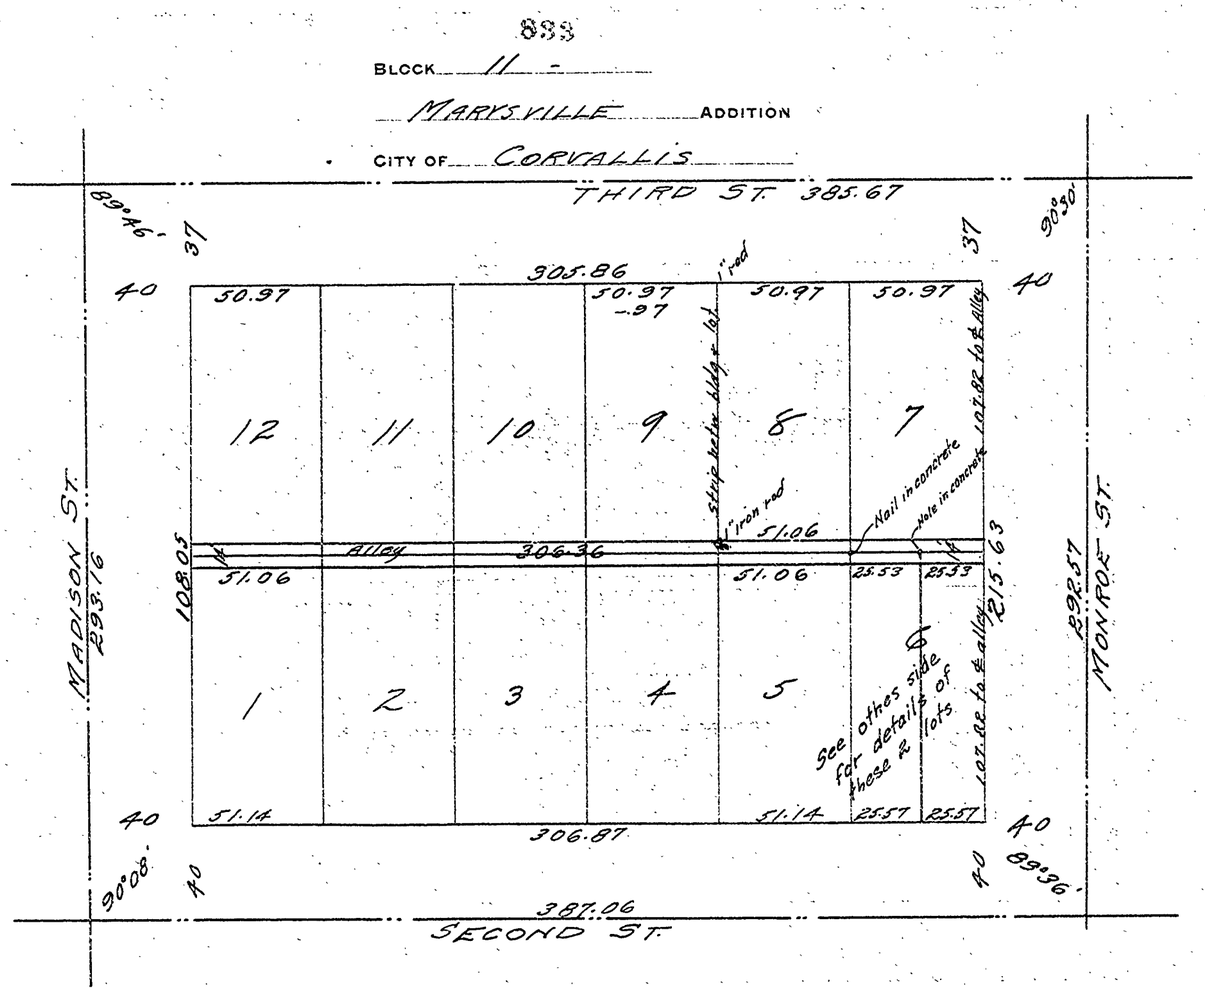

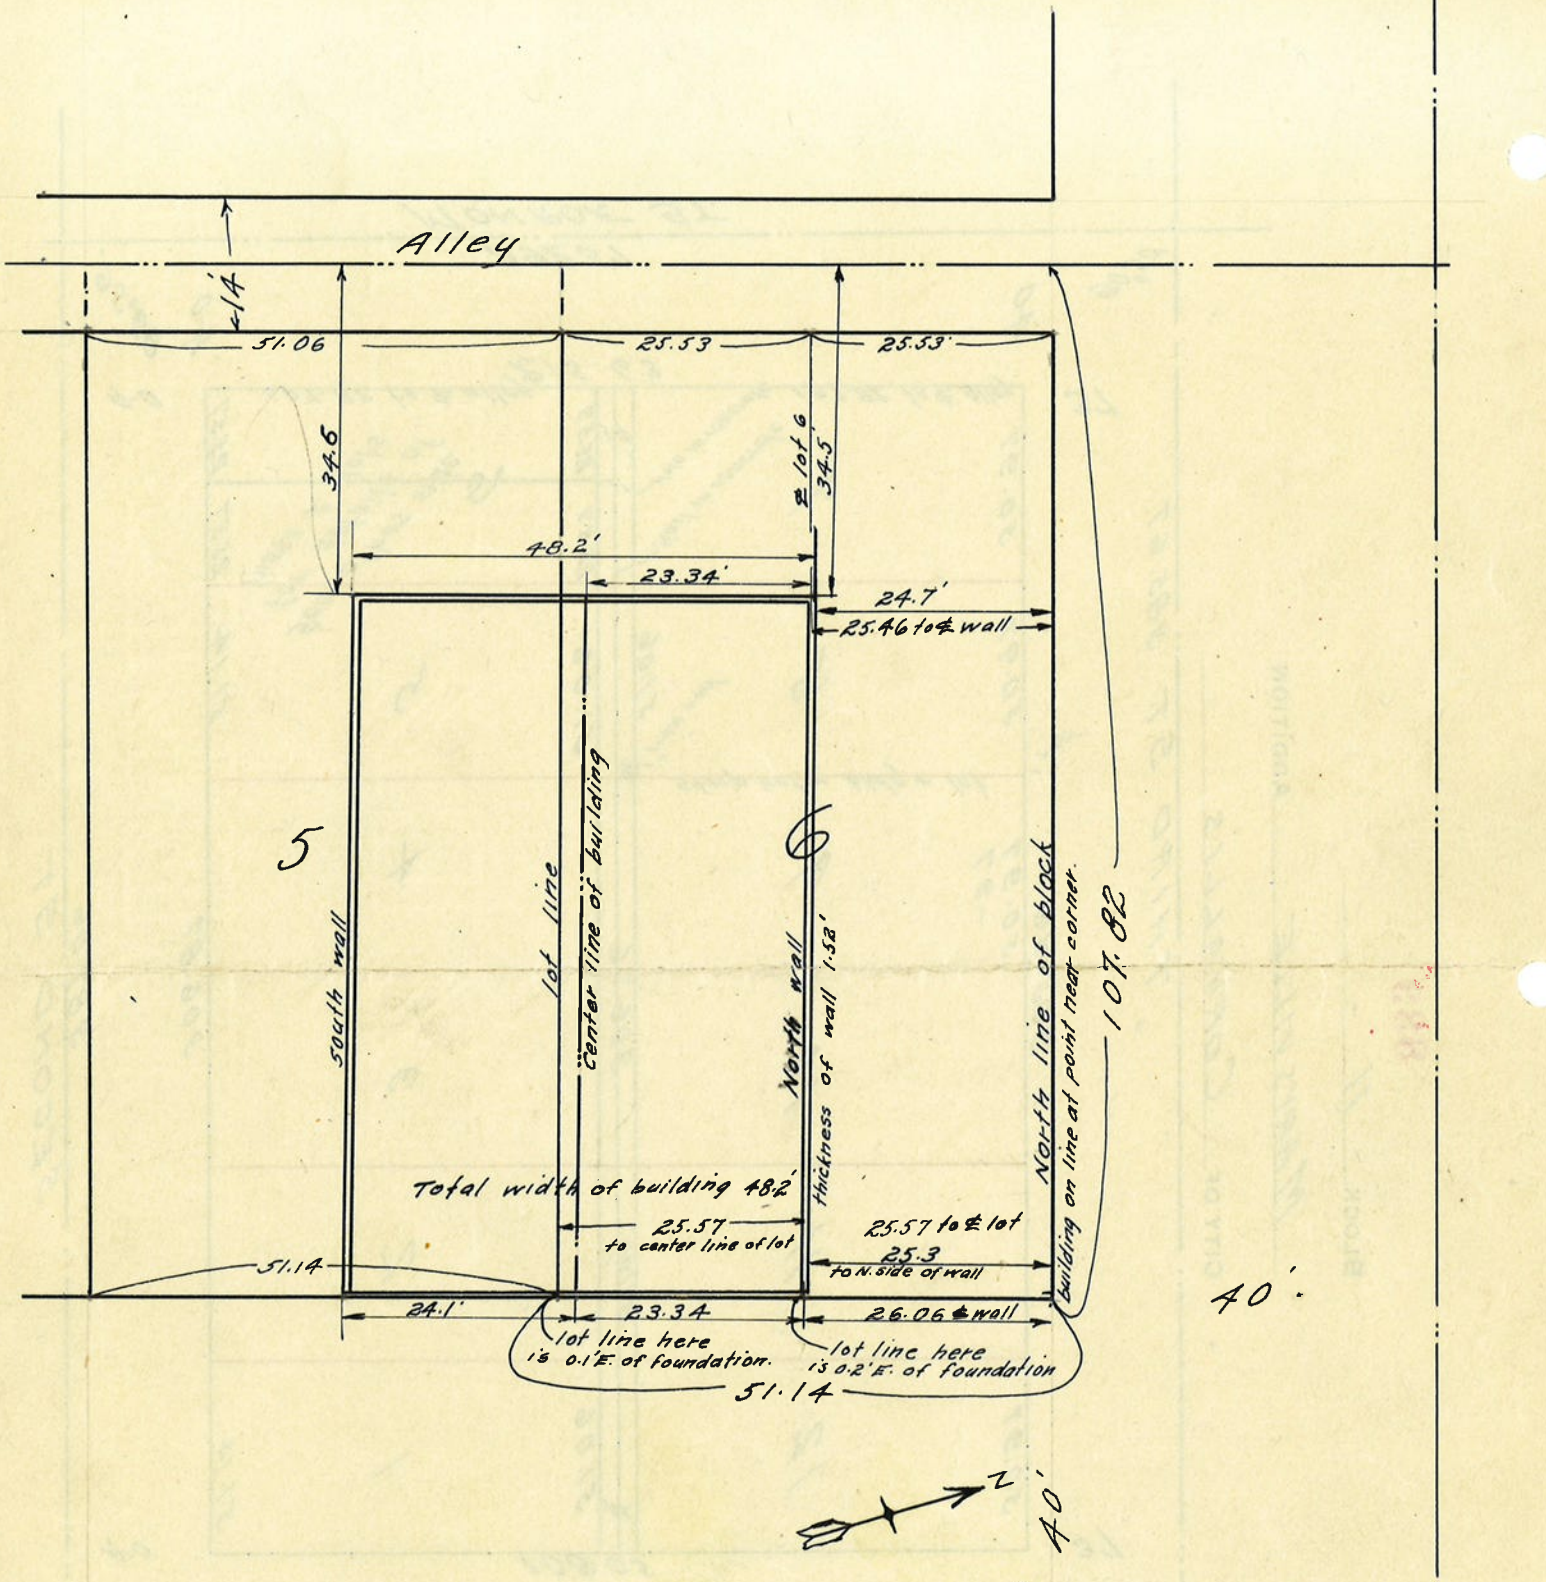
Alley
14'
51.06
25.53
25.53'
34.6
34.5'
± lot 6
48.2'
23.34'
24.7'
25.46 to ± wall
5
6
South wall
lot line
Center line of building
North wall
thickness of wall 1.58'
North line of block
building on line at point near corner.
107.82
Total width of building 48.2'
25.57
to center line of lot
25.57 to ± lot
25.3
to N. side of wall
51.14
24.1'
23.34
26.06 ± wall
lot line here
is 0.1' E. of foundation.
lot line here
is 0.2' E. of foundation
51.14
40'
N
40'