C.S. #835

See notes in file

F.B.

835

10-3 sec31
11-3 sec 6

SURVEY No. 277

Recorded July 28, 1922

Scale:- 1 inch = 4 chains

Survey made for Frank H Hughson and Elmer J. Harder. July 12, 1922

Both parties were given notice by registered letter on July 5, 1922.

Notes of survey:-

Beginning at a 1¼" pipe, the northeast corner of the John Q Thornton D.L.C. 37, T.10S, R.3W, Will. Mer, Benton County, Oregon; from which a stone bears N.76°15'W. 1.92 chains, a fir 24" in diameter bears N.64°23W. 2.456 chains, the southwest corner of a house bears N.6¾°W. 1.53 chains, and a cherry 7" in diameter bears N.50°50'E. 1.226 chains; thence N.76°15W along the south line of the Sarah Adkins D.L.C. 45 17.980 chains to a 1¼" pipe which is S.76°15'E. 1.983 chains from the southwest corner of said claim; thence S.0°03'E. 29.22 chains to a 1¼" pipe - this being the line between the parties above mentioned.
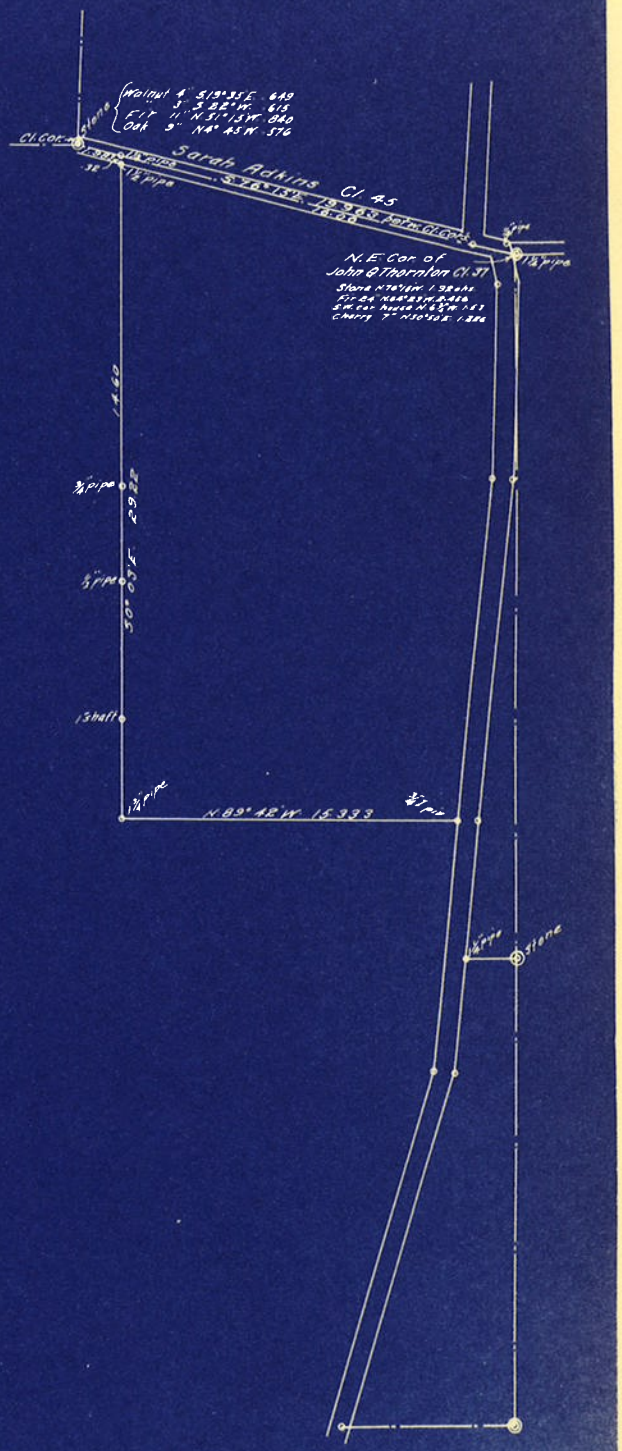
W. C. Galloway
County Surveyor