SEC. 35 T11S R5W

837

Survey made for
Holroyd
By Walter W. Larson &
Holroyd ch.
Aug. 1922

BLOCK 4

Rayburns ADDITION

CITY OF Corvallis

S. P. R. R. 20 Ft. R/W. along the county road

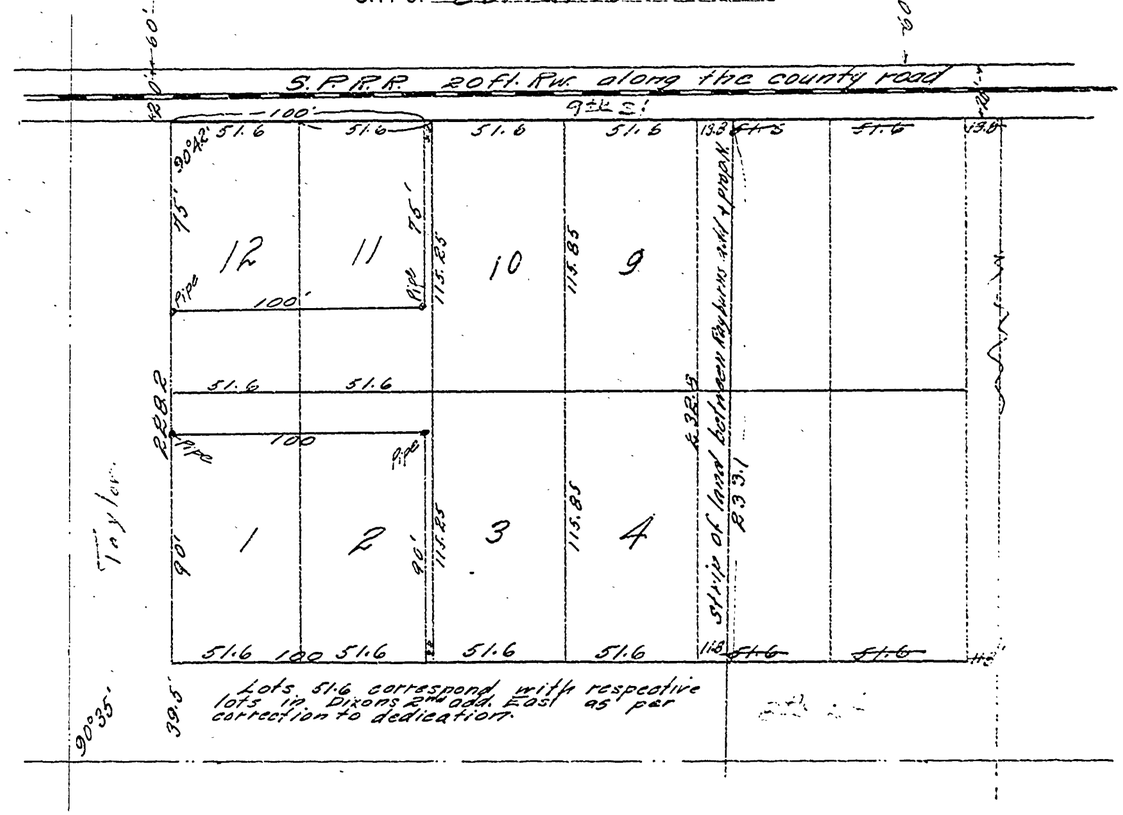

7E