C.S. # 838

Hardcopy 12-6 # 32

also see notes in file

F. B. 33-5

5

838

Copy ✓ C.S. 838 F/B ✓ 33, Pg 5

C.S. 100 Continued.

2" pipe in Stone 2.13 on Sec. line

27/34 + W. line of Clement Barker Cl. 60

T 12-6 from ⊙ N89°58'W on Sec. line offset

	N 1°19'E	-4°5'	5.870 .072E
	N 0°23'W correction W 14½'	+7°10'	6.284
	(N 0°37½'W 33.735)	+11°05'	4.840
		+5°	5.827
		+10°50'	3.595
		leveled	1.612
		level	5.979
	Striking ⅝ of Cor.		.032
			-.204

From 7/8" steel shaft to small sep. .528

From 7/8" steel N. to stake +6°50' 3.775

.79 fence
3.748 = Division Stake
.90 cen. anchor post

Date: Sept 2, 1922
Party: W.C. Galloway
M.R. Good

W. line of A. Majstrik's C.S. #100 cont.
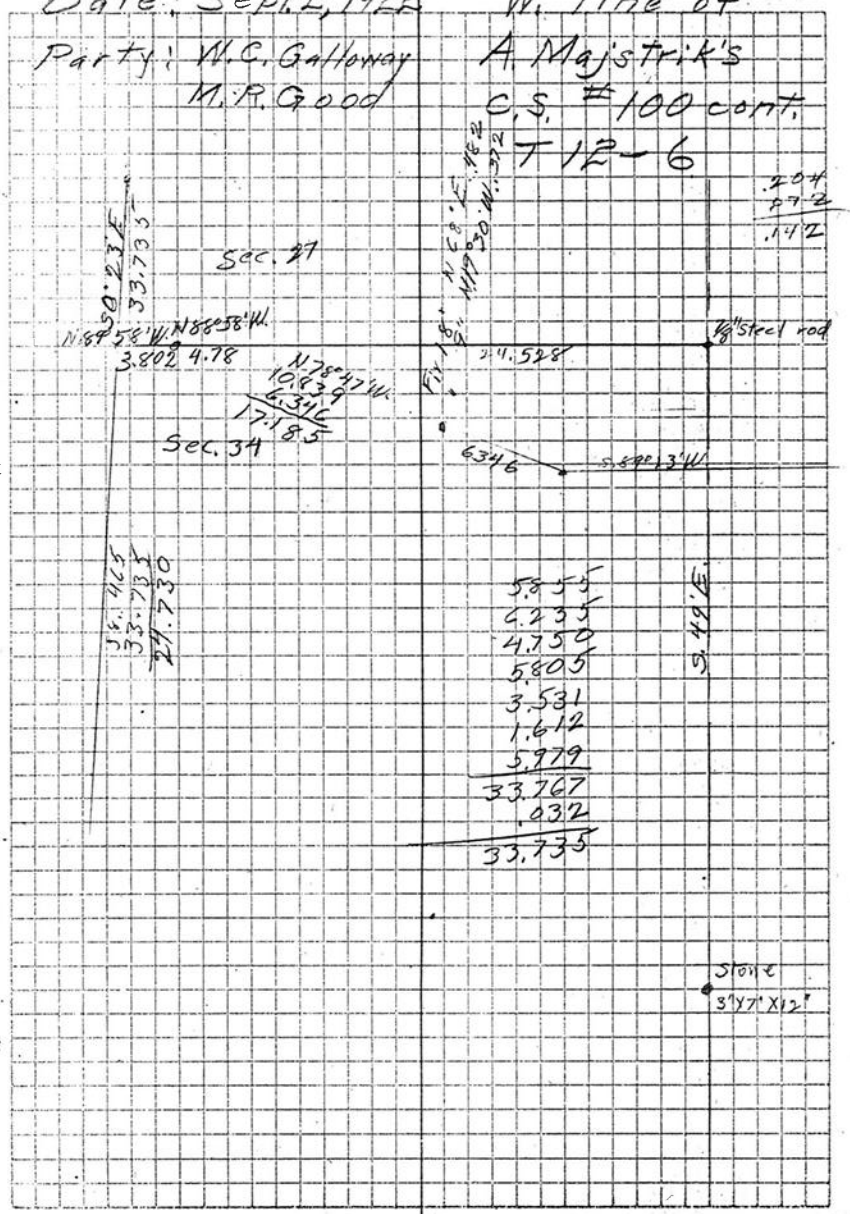
T 12-6