Survey for Dr. Hanford
by W.C. Galloway C.S.
Willard D. Simpson and
Geo. E. Linton assistants.
Sept. 30, 1922

BLOCK 4 848

Mary's ville - Old Town ~~ADDITION~~

CITY OF Corvallis

2nd St.

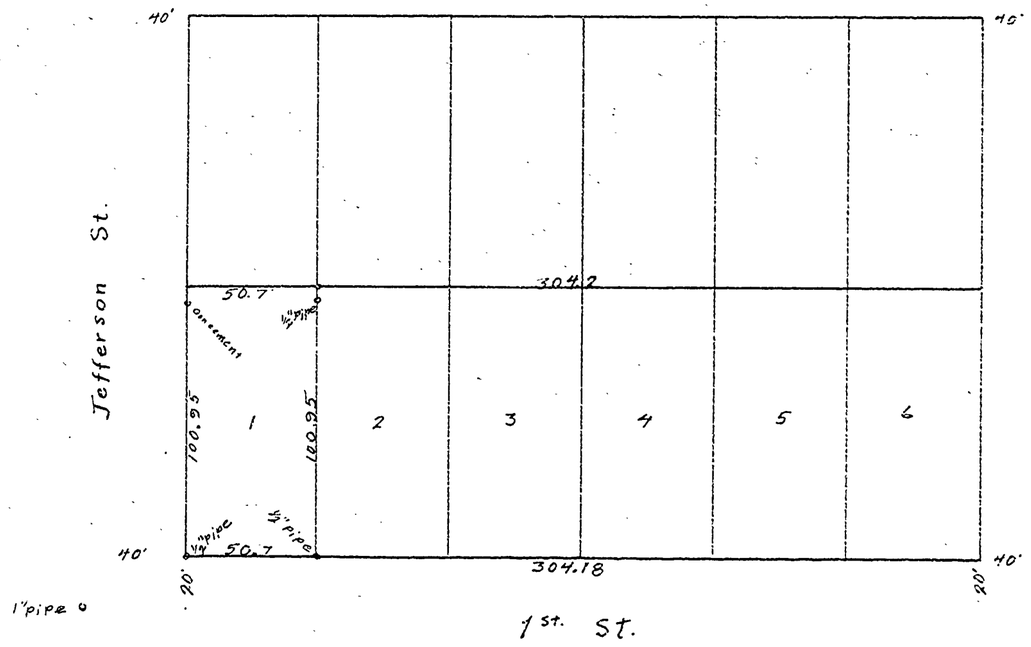

66

843

BLOCK 4

Mary'sville - Old Town ~~ADDITION~~

CITY OF Corvallis

Survey for Dr. Hanford
by W.C. Galloway C.S.
Willard D. Simpson and
Geo. E. Linton assistants.
Sept. 30, 1922.

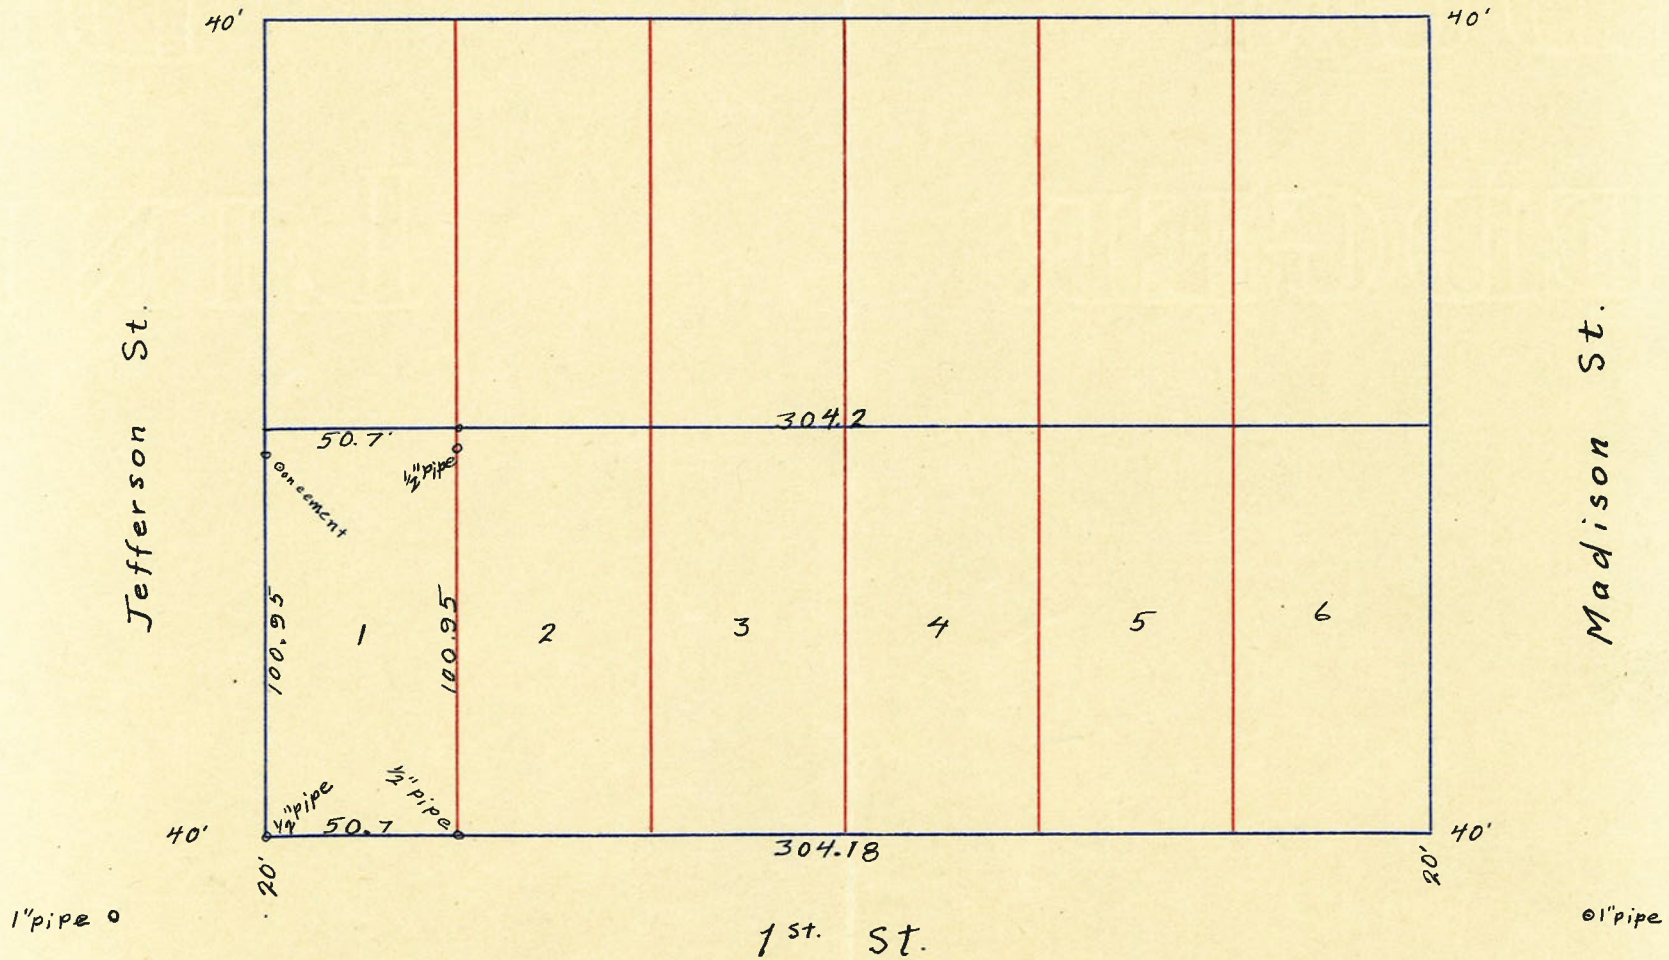

66