845

845

COUNTY SURVEY 292

Johnson Mulkey Cl. 57.

Sec. 32 T. 11. S. R. 5 W. W. M.

Scale 1"=10chs.

W.C. Galloway C.S.

Feb. 5, 1923.

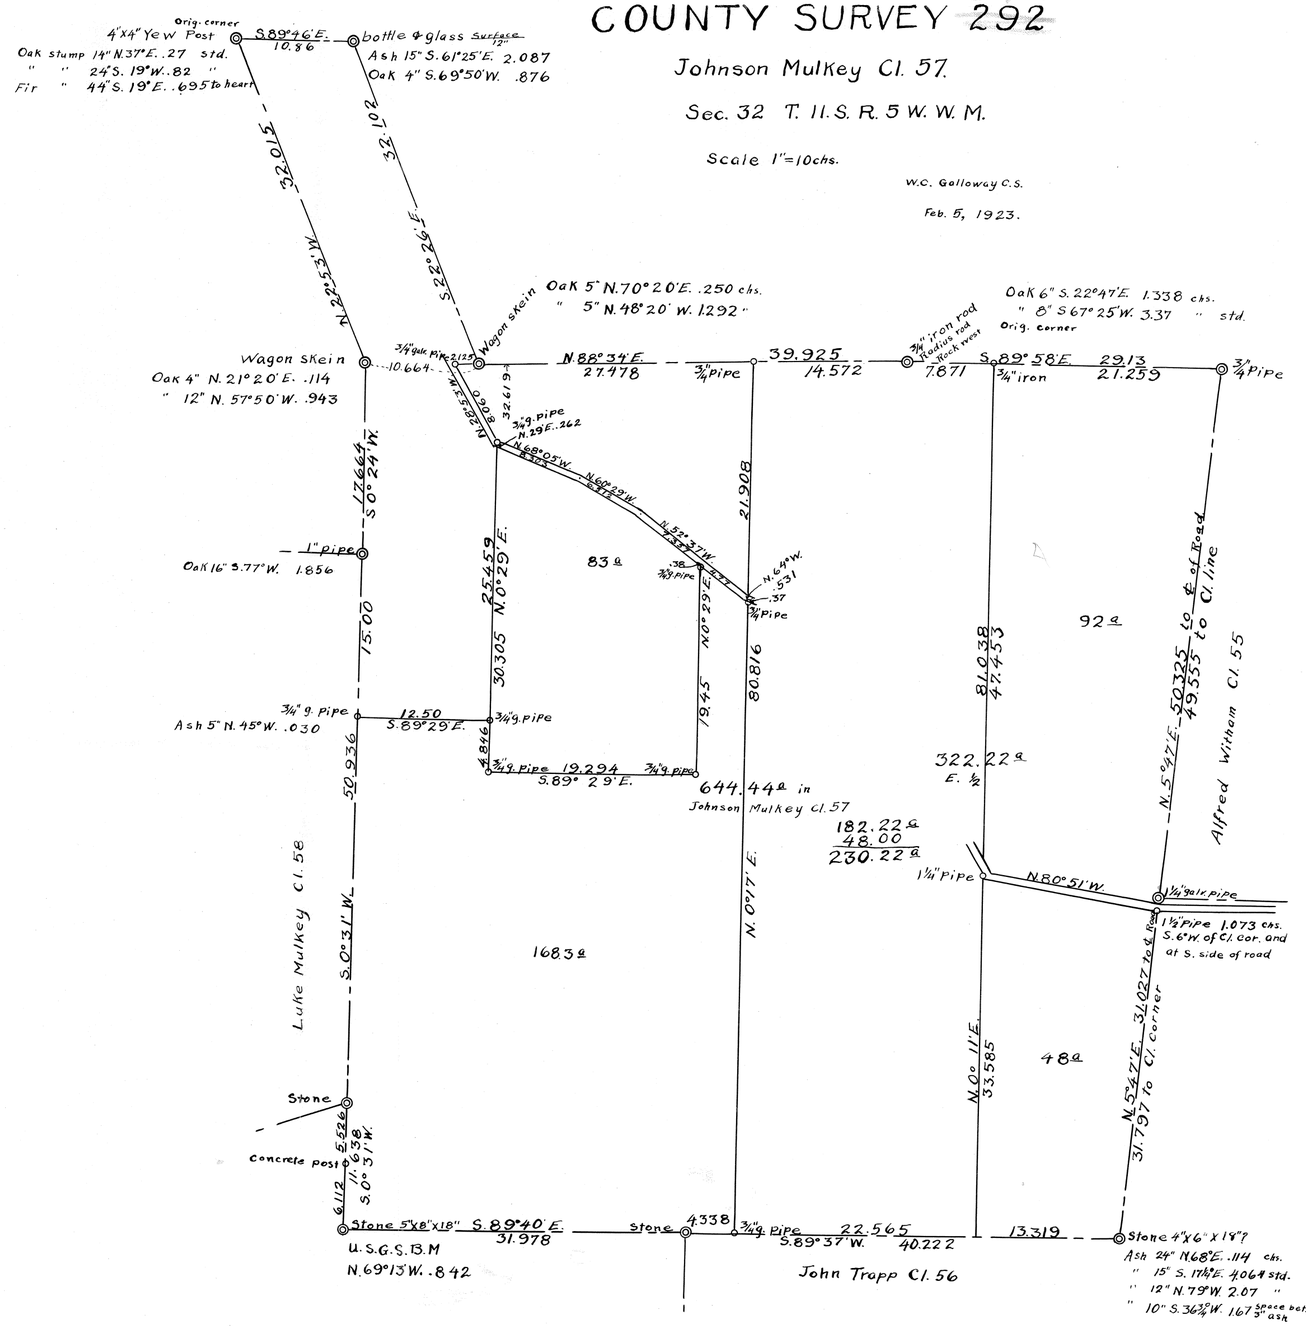

9 C.S. #292 Continued. Copy.

C.S. #845, F/B 33, Pg 9-13 W.C. Galloway

845 Dec. 28, 1922 Party: J.D. Clinton, W.D. Simpson

Beginning at L cor. on N of J. Mulkey C1, 577 11-5

Backsighted S 89° 45' E at NE cor

1	S 89° 19½' W correction S 26½' (S 88° 47' W)		3,234	
2			6,674	3,091 transit
3	Not in total	-3°20'	2,972	+.32 / A line from South
			-.302	S.117
	Service 8" S. side line W.		S.112	
	Set ¾" galv. pipe		-.720	
4	From △2		6,684	S.142
5			4,554	
6		-2°30'	7,244	
7			1,553	
8		-9°35'	6,117	+.086 S.944
4		-11°40'	1,400	+275.7 - 2°36
			+.587	Set Hub S.323 =39.925

Reset. Striking N. of corner .307

Set Wagon skein & rock 8"x16" N.

Oak 5" N 70° 20' E .250 cbs

" 5" N 48° 20' W 1.292 "

Set from old fences.

10	S 89° 13½' W correction N 6' from beginning (S 89° 19½' W 50.589)	-2°	6,634
11		+5°35'	2,578
12		+9°35'	1,881
			+.200
	Striking S of corner		.094

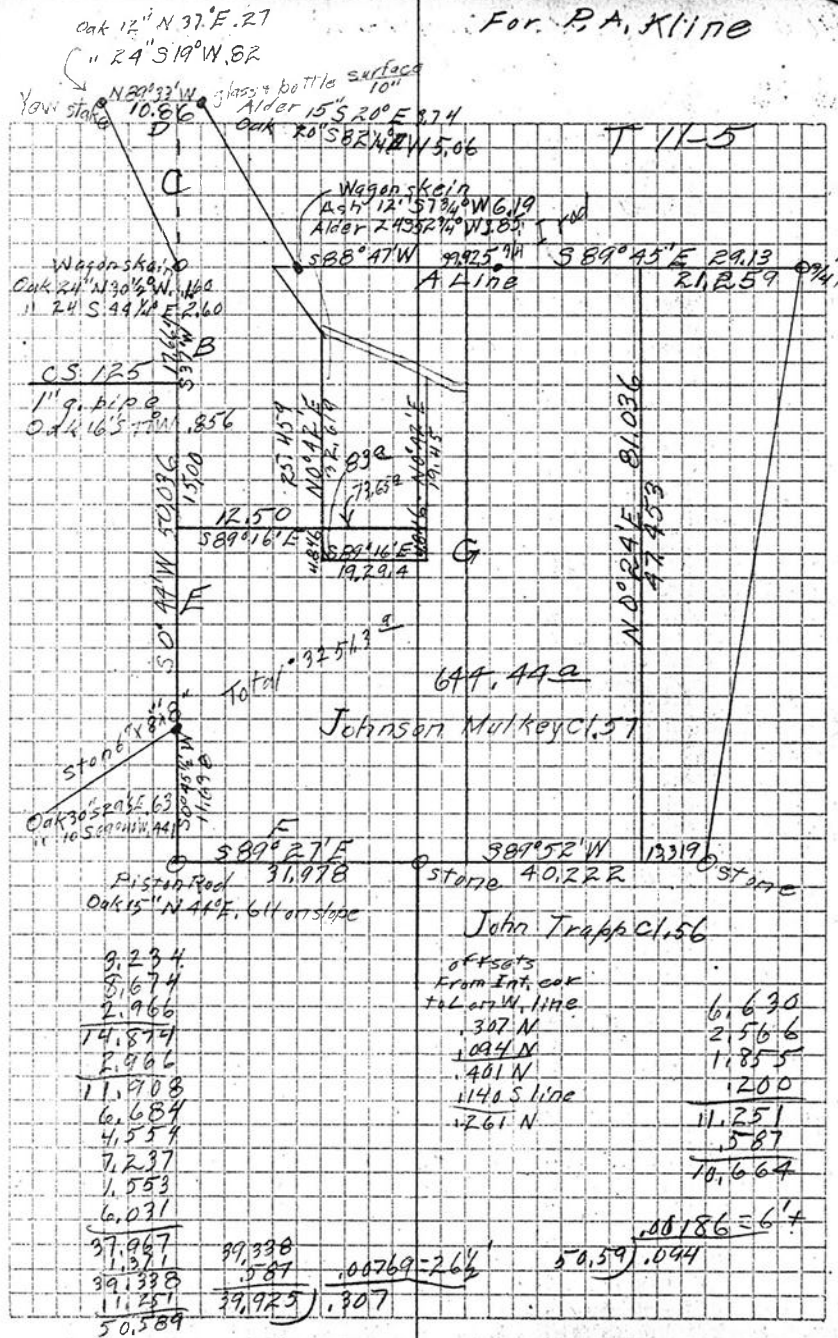

10

Reest.

Oak stump 24 S 44¼° E 1.60 with blaze
N. W. oak pone
Set wagon stein. Bearings from line,
Oak A" N 2¼° E .114 chs,
" 12" N 57° 40' W .943 "

	West line going South		+ .201 E of cor. + .092 S " "	
B 13	S 0° 01½ E correct. on 38½ W (S 0° 37' W)	+7° 50'	3.253	
14		-2° 10'	6.690	+3.25 fence
15		-2° 45'	7.653	
			+.020	
Luke's N.E. cor. of Monkey	Stinking E of pine		.399	

Back to Δ 12

Δ 12 is .201 E + .092 S

C	North	-10° 35'	2.34	
		-1° 10'	8.000	
		+1° 18'	8.000	
16		+1° 50'	4.033	
17	∠ L. 0° 11½'	+1° 46'	5.723	offset .019 W of cor.
18	∠ L. N 49¾ W	+6° 5'	2.175	1.650 W
		ser cor. W. 011 + N .088		of Δ 18

Reest.

Set bottle & glass for cor.
Ash 15" S 61¼° E 2.087 chs.
Oak 4" S 70° W .876 "
" stump S 82¼ W 5.06 "

D 19	West correction +.77' (N E 9° 33' W)	-6°	6.134	

offsets
B. Line
.201 E
.399 W
17.664 .198 W (.01121 = 38½')

offsets
For C Line
Line from cor. 29.547 12.739
.201 E
.019 W
.182 E
1.668 W
1.486 W
.101 W
10.860 W
12.539 W

1.479 W
10.663 W
12.142 W of E Ext. cor.

.092
3.223
6.685
7.644
.020
17.644

.41768 = 22° 46'

2.300
.092
2.208
1.998
1.998
4.028
22.232
5.720
27.952
1.417
.088
29.457 to NE Ext.
.085
29.542 N W cor.

(see next page)

11

		+15°50'	.4933	
			+.025 =	10.860
Reest. 20			.173	
(N.W. cor. J. Mulkey orig. cor.)	Striking S of cor.			
	Set 4"x4" Yew stake 30" "ZZ" in ground			
	Sat stamped "1" N 37° E. .27 chs. orig			
	" " Z4" S 19° W .62 " " .			
	Fir stump 44" S 19° E .695 " heart.			
	Back to Δ15 which is		E .399 from pipe	
			N .026	
	S 0° 50' W correction E 5'	-1° 30'	8.000	
Z1	(S 0° 45' W)		6.919	
			+.110	~~=50.935~~
	set ¾" galv. pipe 30" long		+W .377	
	Ash 5" N 45° W .030 chs			
Z2			.550	
Z3			7.562	
Z4			3.999	
Z5		+8° 20'	7.340	
Z6		+5° 45'	4.792	
Z7		-1° 50'	5.117	
Z8		+10° 25'	6.895	
			+.010	=50.936
	Striking E of corner	+15° 15'	.323	
			5.730 =	5.528 from stone to concrete post
	S 0° 50' W correction E 4½' (S 0° 45½' W)			
	Striking E of cement post		.316	
	" " " " "		.308	
	Set stone 5"x8"x18" Cor. E 95T. U.S.G.S. B.M. N. 69° W .842 chs.			

6.100	offsets	.40857 = 22°13'
.011	D. Line	29.718) 12.142
6.089	.0885	32.015
4.746	.1773 N	.92774) 29.542
.075	.1085 N	32.102
10.860) .085 (.00783 = 27'		.92576) 29.718

offsets
.3992
.3231 W
.076 W

50.936) .076 (.00152 = 5'

7.997
.026
7.971
6.919
14.890
.550
7.562
3.999
7.562
4.768
5.114
6.781
.010
50.936

G line Jan. 13, 1923 Party: W.C. Galloway, William Simpson

Set ¾" galv. pipe E .670

N 0° 06' E correction E 24' along division line from ⊙ on Cl. line 4.268 chs. N 89° 52' E of N.W. c of John Trapp cl. 56

33			15,006	
34			15.119	
35			6.623	
36			8.003	
37			5.516	E .416
			7.581	
38			1.290	℄ Road
				=59,138
			E .479	
		+2° 45'	8.000	
39		+3° 20'	6.876	E .582
40		+6	3.787	
41		+9° 45'	3,198	+.005 To transit line W of F.32, 326 S 89° 17' W
			−.112	
		N 89° 48' E	.628	

Back to ⊿ 38

42	N 52° 24' W	℄ road	12.127	
43	N 60° 16' W		2.262	
44			4.250	
45	N 67° 52' W		8.099	−.386 To cor. Set ¾" G.P.
46	N 28° 40' W		8.450	To cor. at E side of Road

offsets on G line

.070 W
.628
.558

.00694 = 24'

80.816) 55.8

Guess at S 64° E .531 Set pipe S. 37

80,816
59.138
E 1.678

4.268
.070
4.338

15,006
15.119
6.623
8.003
5.516
7.581
1.290
59.138
7.991
6.866
3.766
3.152
80.913
.112
80.801
.015
80.816

8.450
.386
8.064

2.262
4.250
6.512

N 8° 49½' E to cor.

13

	Back to △ 8				
	S 0° 12' W	-7°	3,030	+.037	
		-2°5'	4,785	To Gin Road	
47			-.336	S 67°50' E	
			W.190		
48	S 0° 45' W		8.787	W.185	
	correction E 2'				
49	(S 0° 43' W)		14,640		
50			2.541		
			-.847		
			+ W.172		
	West (N 89° 57' E)		12.299	+.372	
	correction 48' N		-.003		
	(N 89° 12' W)				
	Striking S of △		.576	N 0°53' E	
	Back to △ 50 Set N 0°45' W		.847		
	S 89° 57' E				
53	correction E 45'		19.111		
			+.011		
	set Stone		.244		
54	N 0° 48' E		14,360	℄ road	
	correction W 5'			S 52° 24' E	
	(N 0° 43' E)			set pipe -38	
	Set ¾" galv. pipe at		-.38		
To 38	S 52° 24' E		4,770		

offsets
going S.
.086 E
.072 E
.153 E
.172 W
.022 E

3.007
4.781
7.788
.292
7.496
8.787
14.646
2.541
33.464
.845
32.619
7.496
25.123
.336
25.459

12.249
.372
12.672

4.846
.244
5.090

.244
14.360
14.604