852

852

10-4
33 & 34

COUNTY SURVEY NO. 353

FOR N. H. HANSEN W.C. GALLOWAY C.S.

JACOB L. HALTER D.L.C. NO. 73

SECTIONS 28 & 33 T. 10 S., R 4 W., SCALE 1" = 10 CHS.

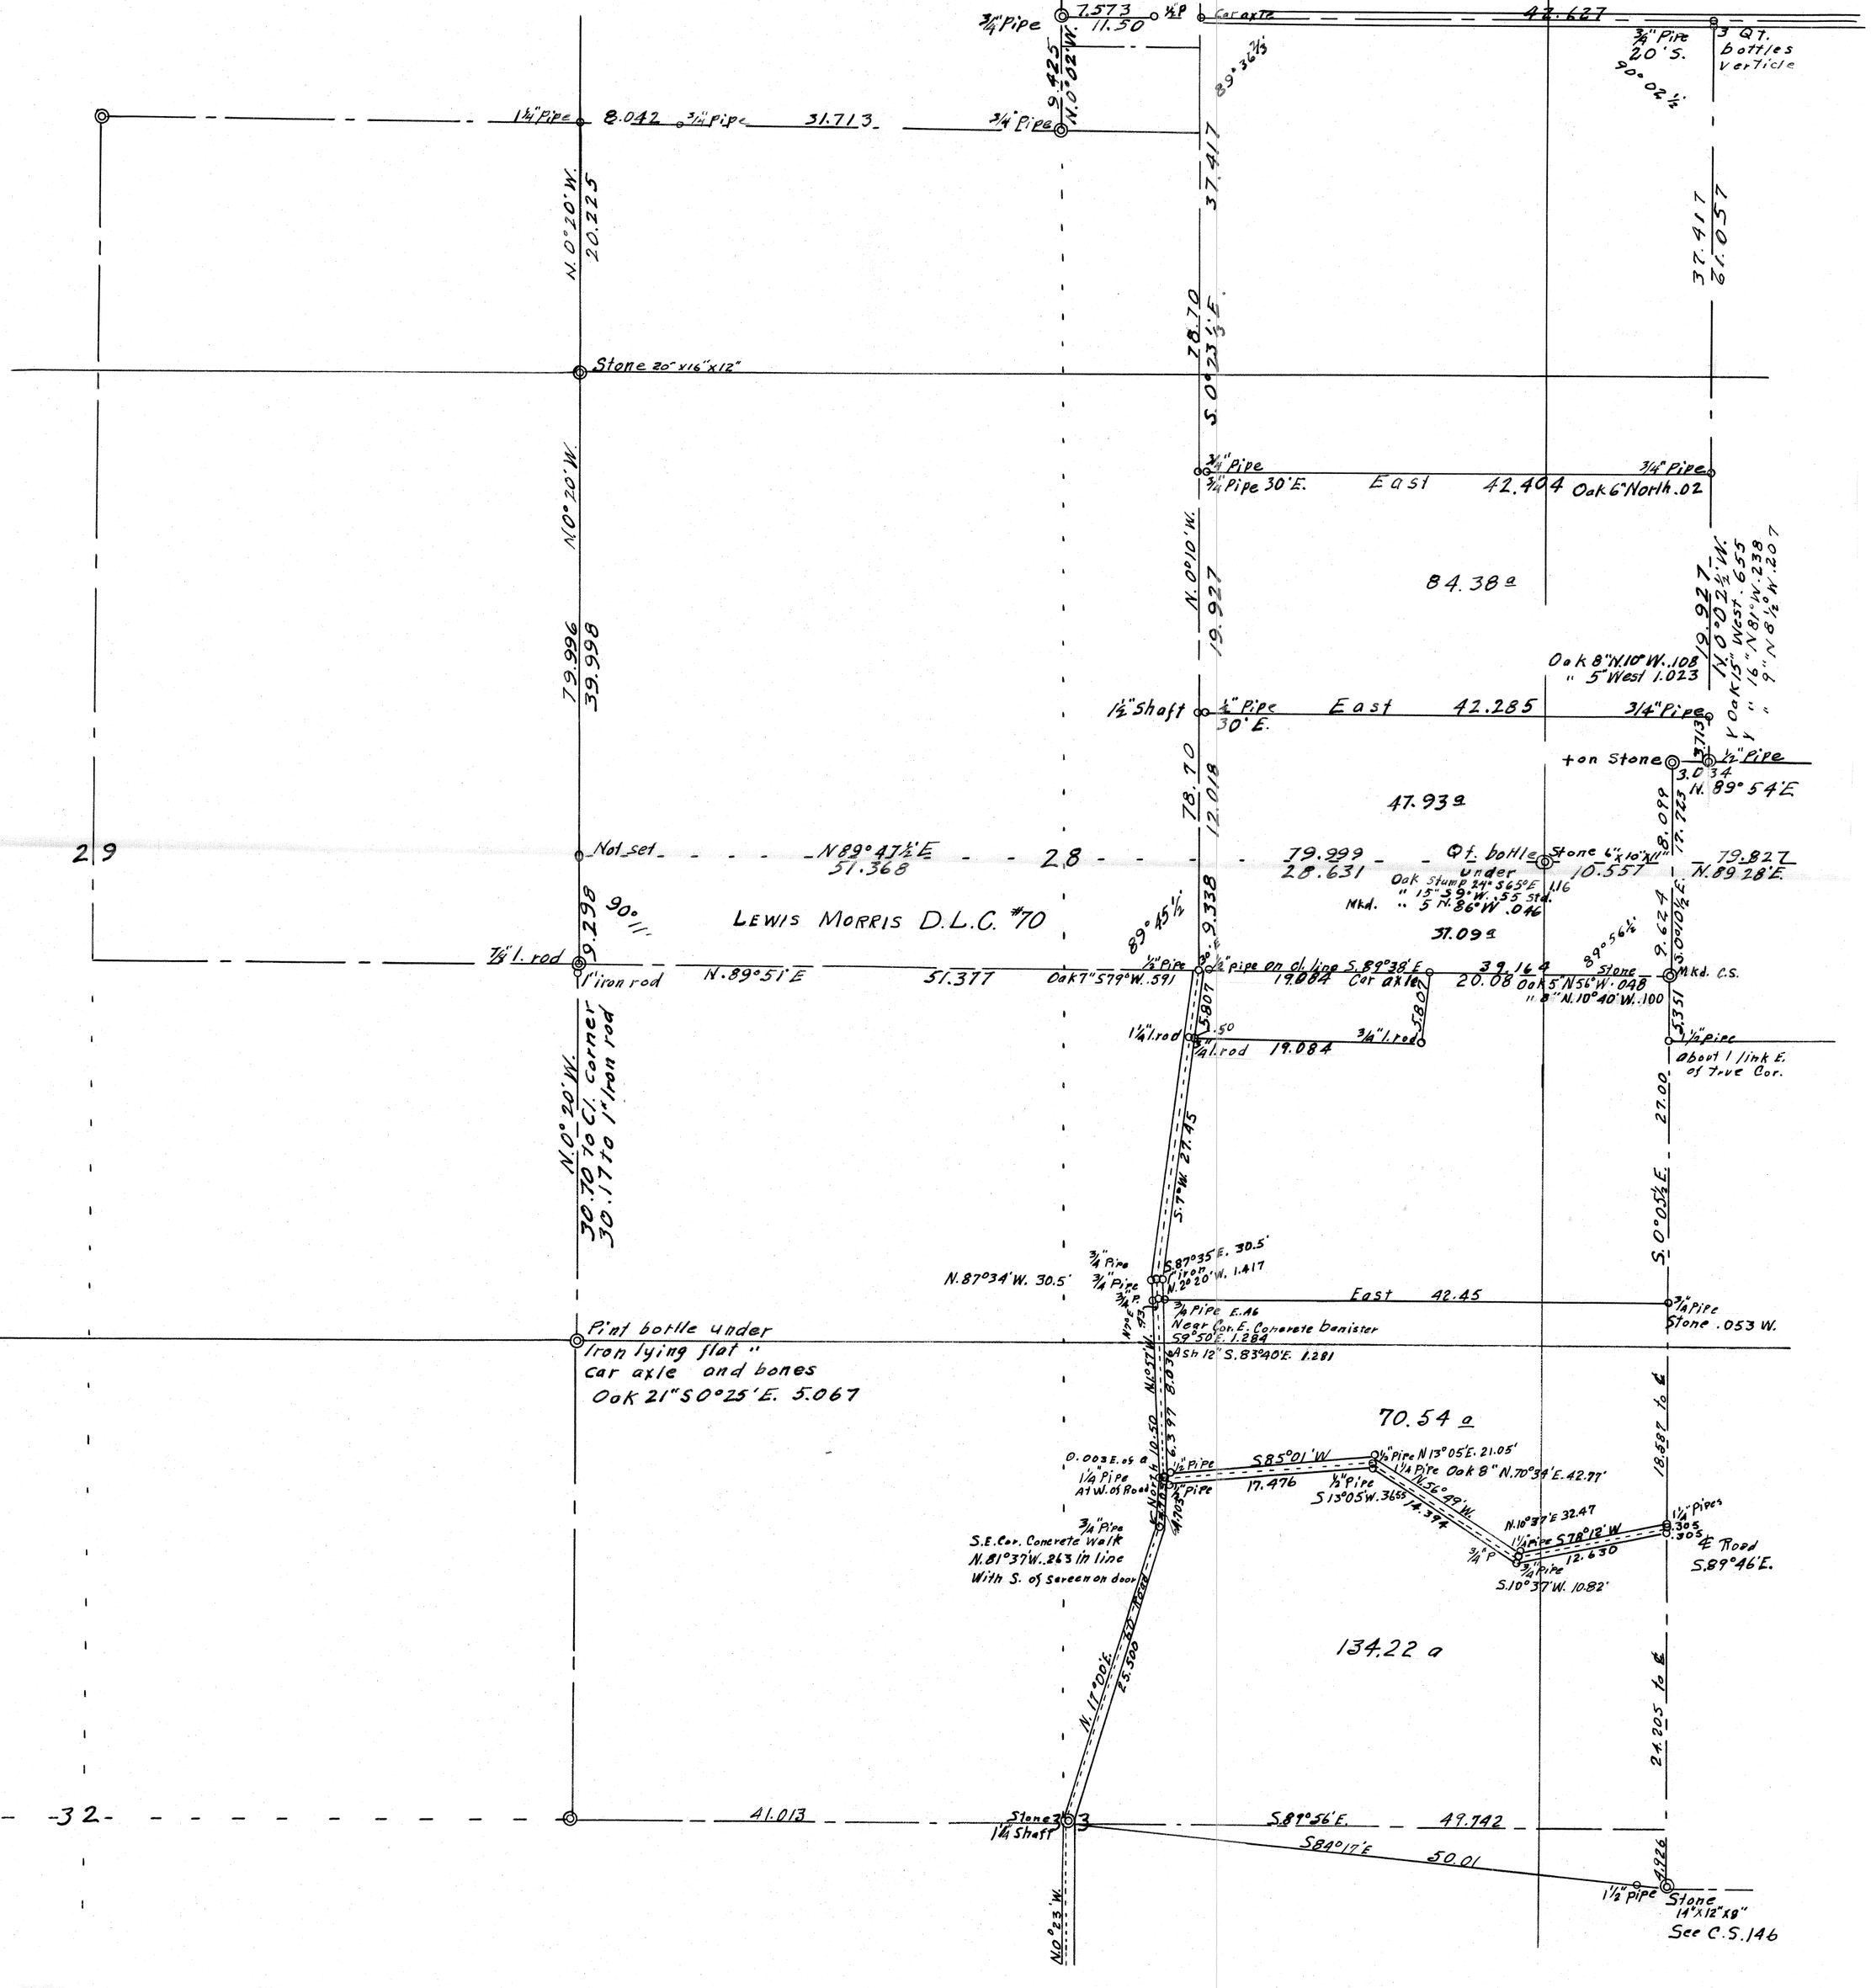

33

MINING
TRANSIT BOOK
363

27 C.S. #293 of Roads

Copy

852 Beg. at S.E. cor. of Lewis Morris D.L.C. 70 T 10-4

Backsighted on Cl. line 95 North

Thence S 7°26' W	-2°15' thru		
	-3°	8.000	
	-3°	8,000	
	-1°45'	8.000	
		2,064	=26.036

To ¾" pipe Set ¾" pipe N 87°35' W. 30.5'
" 1" Iron + S 87°35' E, 30.5
To N.E. cor. post of Concrete bridge R. 6.98

S 2°25' E		8,000	
	+1°15'	8.257	

To ½" x 1½" x 16" Iron bar
set ⅝" bolt N. 20° E 30' on Road lines
" ½" g. pipes 20' E 30' " " "
" stick S 85°11' W 30' " " "

Thence

N 85° 11 E	-3°30'	2,968	+3.31 to bridge
		8,000	
	+1°	6.515	

~~Set 1¼" g. Pi~~
oak 8" N 70° 45' E .648 chs
½" g. p. S 13° 16' W .478 "
½" g. p. N 13° 16' E .319 "

S 56°39' E	+1°45'	2.789	
	+3°45'	8.662	
		2.962	=14.394

Set ¾" g.p.
set 1¼" g. p. N 10°48' E .492 chs
and ¾" g.p. S 10°48 W .164 "

Date: March 1923
Party: M. C. Galloway
S. J. Galloway
B. K. Taylor

T 10-4

7.989
7.989
7.994
2.064
26.036

2.962
8.000
6.514
17.476

2.788
8.644
2.962
14.394

28

N 78° 22' E 8,000 +∠45°06'

+1°45' 3,195

1,437 = 12.630 To 1¼ pipe

set 1¼" g. pipe N2'E .305

" 1¼" " " S2'W .305

S 89°36' E To @ 20'S. of

Anthony's S.E. cor. Int. ∠ 90° 24½'

11251 Re survey of Road #47 T 10-4

Beg. at ℄ of Road 47 on Polk Co. line

Thence S 2°56' W 14.52 obs. to 1¾" pipe

1.314 set ¾" g.p.

S 50° E ½" pipe → 4SW

set 1¼" g. pipe and set 1" g. pipe N54°30'E .519

4,234

S 21° E

S 2°37' W 3,330 set 1¼ g. pipe N81°20'E .492

set 1" pipe 20,000

Oak 11" N 44°15' E .639

" 20" N 52° W .683

U.S.G.S. B.M. N 30° E .142

S 75° E.

4,467 set Qt. bottle

S 1°30' E 5,22

set 1¼" pipe

S 23° 42' W 13.386

set ¾" pipe

Set 1¼" shaft N 70°06' W .456

S 15° 46' W 22.736

Set ¾" pipe & ¾" pipe S 75°39' E .457

¾ " N 75°39' W .457

Lined from @ .075 E of I to @ 30' E of Yew Stake S 49°56' W 1.02 to Yew stake

---

on Cl. line N 0°02' E

S 50° E

14.52
1.314
15.834

65,255
4,926
70,181
68,597
1.584
.291
1.293

29,955
7,997
7,974
2,401
5,400
7,276
7,994
68,597
1,370
69,967
4,926
65,041
5,351
70,392
To NE cor. of Cl. 70

Dave Vanderpool's N.E. corner

7,443 plow shear to 1¼" pipe W.
4,773 S. of Plow shear to 1¼" pipe

→ Oak 18" N 70° E .76
1. 18" S 24' E .61 not marked