C.S. # 854

Hardcopy 14-6 #6

also see notes in file

F. B. 30-1

FB#30

Sec. 11 T. 14 S. R 6 W.
C.S. 149 con.

Survey for A.L. Wilkinson
Bellfountain

#854

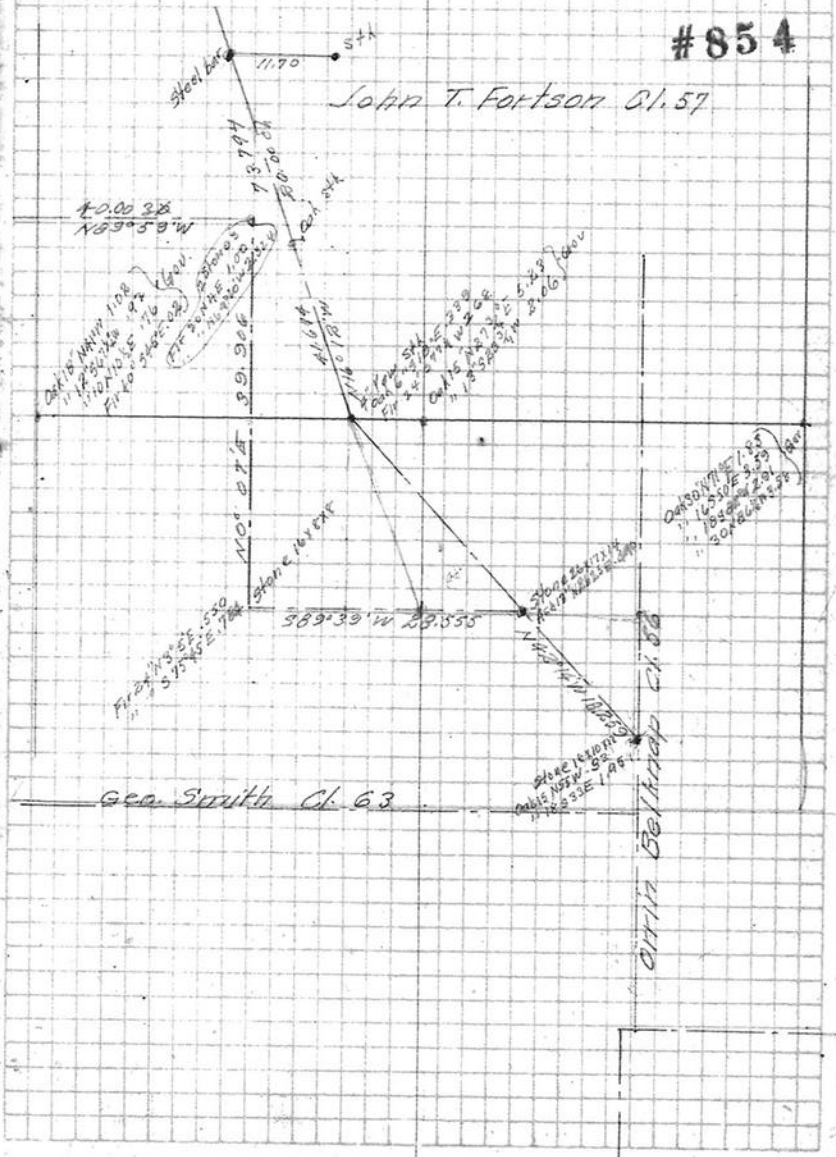

2

Survey for A. L. Wilkinson

Began at stone - the cor of Geo. Smith Cl.

+21°				
4.582	4.278			
			S 89° 07' W	.041
+14° 10'				
1.870	1.813		Correct N 0° 32'	
			= (S 89° 39' W)	.057
+10° 45'				
2.360	2.319			
		0° 15' R		.078
+13° 45'				
2.662	2.596			
		0° 15' L		.090
8° 30'				
3.664	3.624			
				.122
+8°				
1.704	1.687			
				.139
-3°				
2.370	2.367			
				.160
-6°				
4.970	4.943			
		0° 17' R		.205
0°				
4.940	4.940	28.571	S 89° 24' W	
	.004			
Δ				
		90° 45' R		
-20° 30'				
4.60	4.596	N 0° 9' E		
				.003 W
-13° 30'				
4.065	3.953			
		0° 20' L		.006 W
+36° 10'				
2.280	2.046			
				.001 E

T. 14 S R 6 W

April 27, 1923

041
017
058
021
079
024
103
012
091
034
125
016
141
022
163
096
209
146
255
020
275

.00436
206
2616
2616
872
.011 947 6

N. 012
N. 025
N. 224

25.555) N .26100 .00932 = 0° 32'
2006745
54005

Correct N 0° 32'

S 89 39 W
32
S 89 07

~~S 89° 07' W~~
N 0° 07' E
= 91° 0'

.00495
5
.02475

S 5° 55' E .224 to cor
+.004

3

+18° 30'			for 2nd y. 0°24'R		
2.346	2.220			.009 W.	
				1°48'R	
+2°					
1.120	1.120				
		1°48'L	" 0°0'	.043 W	
-4° 30'					
3.473	3.461				
				.045 W	
-10°					
1.660	1.635	18.817 Contofne.		.046 W	
		86° 12'R.			
+20° 15'					
5.000	4.691				
-1° 15'					
5.000	4.867	N 86° 21'E			
1.110	1.110 .064				
	10	51° 25'R			
-5° 10'					
5.000	4.980			.035	
-24					
5.000	4.997	S 42° 14'E		.070 L	
3.263	3.263			.043 L	
5.160	5.160			.124	
1.970	1.970			.143 L	
+3° 40'					
4.980	4.970				
-8° 10'	(1.120)	10°12'L		.178	
1.053	1.042	S 52° 26' E		.186 L	
26.42	26.366	141° 50'			

2 5.34
1.042
26.366

-.580 old line .025 W

+.020 Barb fence

New Str 020 S of fence

.035
.035
.070
.023
.093
.036
.129
.014
.143
.035
.178
.07
.185

.00704 = 0° 24'

26.42 1.87000
1584 4
11600